- S SIDE ONE *** TIGHT HOLE ***

STATE CORPORATION COMMISSION OF KANSAS
OIL & GAS CONSERVATION DIVISION
WELL COMPLETION OR RECOMPLETION FORM
ACO-1 WELL HISTORY
DESCRIPTION OF WELL AND LEASE

API NO. 15-.179-20,864 34-9-26W Wnds?

County Sheridan

SE NW SW Sec 34 Twp 9S Rge 26 X East / West

1650 Ft North from Southeast Corner of Section
4290 Ft West from Southeast Corner of Section
(Note: Locate well in section plat below)

Lease Name Newman Well # 2

Field Name Fuller North Extension

Producing Formation D&A

Elevation: Ground 2616 KB 2621

Operator: License # 4569
Name Jay Boy Oil, Inc.
Address 8400 Killarney
City/State/Zip Wichita, KS. 67206

Purchaser N/A

Operator Contact Person C.K. Morrison
Phone 316-263-5781

Contractor: License # 5418
Name Allen Drilling Co.


Wellsite Geologist Chuck "Dusty" Rhoades
Phone 913-743-5419

Designate Type of Completion
X New Well __ Re-Entry __ Workover

__ Oil __ SWD __ Temp Abd
__ Gas __ Inj __ Delayed Comp.
X Dry __ Other (Core, Water Supply etc.)

If OWWO: old well info as follows:
Operator
Well Name
Comp. Date Old Total Depth

Section Plat

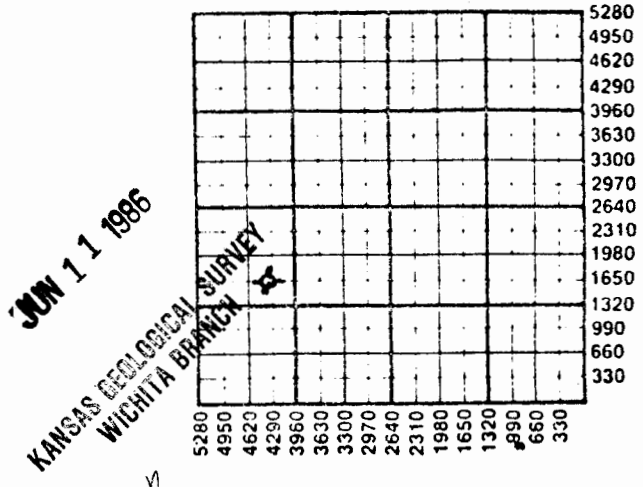

JUN 11 1986
KANSAS GEOLOGICAL SURVEY
WICHITA BRANCH

X WATER SUPPLY INFORMATION

Disposition of Produced Water: __ Disposal
Docket # __ Repressuring

WELL HISTORY

Drilling Method:
X Mud Rotary __ Air Rotary __ Cable

4/30/86	5/7/86	5/8/86
Spud Date	Date Reached TD	Completion Date

RTD 4130
LTD 4132 N/A
Total Depth PBTD

263'@270' KB
Amount of Surface Pipe Set and Cemented at feet
Multiple Stage Cementing Collar Used? __ Yes X No
If yes, show depth set feet
If alternate 2 completion, cement circulated
from feet depth to w/ SX cmt
Cement Company Name
Invoice #

Questions on this portion of the ACO-1 call:
Water Resources Board (913) 296-3717

Source of Water:
Division of Water Resources Permit #

__ Groundwater Ft North from Southeast Corner
(Well) Ft West from Southeast Corner of
Sec Twp Rge __ East __ West

__ Surface Water Ft North from Southeast Corner
(Stream, pond etc) Ft West from Southeast Corner
Sec Twp Rge __ East __ West

X Other (explain) SW. from #1 Newman (NW NW SW)
(purchased from city, R.W.D. #)

INSTRUCTIONS: This form shall be completed in triplicate and filed with the Kansas Corporation Commission, 200 Colorado Derby Building, Wichita, Kansas 67202, within 120 days of the spud date of any well. Rule 82-3-130, 82-3-107 and 82-3-106 apply.
Information on side two of this form will be held confidential for a period of 12 months if requested in writing and submitted with the form. See rule 82-3-107 for confidentiality in excess of 12 months.
One copy of all wireline logs and drillers time log shall be attached with this form. Submit CP-4 form with all plugged wells. Submit CP-111 form with all temporarily abandoned wells.