

Section 27 Township 9 Range 17 WWell No. # 1 WesthusinCompany Lohman & Johnson

NORTH

0							

SOUTH

WEST

EAST

Rooks KANSAS

SEC.	TWP.	R.
27	9	17W ✓

WELL NO.

1 Westhusin

FARM

COMPANY

Lohman & Johnson

CONTRACTOR

Lohman & Johnson

Wildcat


990 Ft. from N. Line

Ft. from S. Line

Ft. from E. Line

330 Ft. from W. Line

SW NW NW

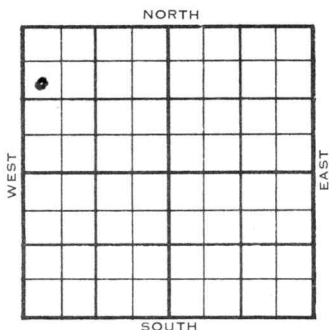

	ELEVATION	REPORT
1953	2086'	
12/30	Spud 12-26-53 8" @ 208' Drlg. 1400'	
1954 1/6	Heeb 3225' Tor 3244' Lans 3264' DST 3265'-83, 1/2 hr, 10' M B KC 3502' Cong. 3532 Drlg. 3614'	
1/13	NR	
1/20	D&A	
2/10	"	
2/17	Spud 12-26-53 D & A TD 3690' 8" @ 208' Heeb 3225', Tor 3244', Lans 3264' DST 3265'-83' opn 1/2 hr, rec 10' Mud B KC 3502', B. Penn Cong. 3532', Arb 3646' TD 3690' D & A	

ABANDONED

County **Rooks** State **Kansas**

Sec. **27** (Blk.) **9** (Sur.) **17W** Map No.

Operator **Lohman & Johnson**

Well No. **1** Farm **Westhusin**

Elev. Location **SW NW NW**

0									

FIRST REPORT

990 Ft. From **N** Line **NW**

330 Ft. From **W** Line Quarter

1st. Report **DEC 30 1953**

Completion


Remarks

Lohman & Johnson - Contr.

Spudding Date **12-26-53**

Drlg. Data **Wildcat**

8" @ 208 drlg. 1400

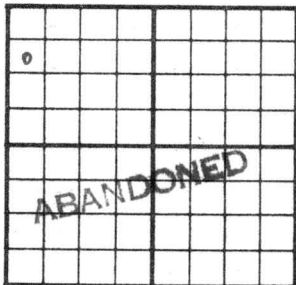County Rooks State KansasSec. 27 (Blk.) 9 (Sur. Rge.) 17W Map No.Operator Lohman & JohnsonWell No. 1 Farm WesthusinElev. 2086 Location SW NW NW990 Ft. From N Line NW330 Ft. From W Line Quarter

1st. Report

FEB 17 1954

Completion

Remarks

WildcatLohman & Johnson - Contr.Spudding Date 12-26-53Drlg. Data D & A TD 36908" @ 208 Heeb. 3225 Tor. 3244Lans. 3264 DST 3265-83 open $\frac{1}{2}$ hr.Rec. 10' mud B KC 3502 B. Penn Cong. 3532Arb. 3646 TD 3690D & A

J. G. McGEHEE