


Section 27 Township 9 Range 18W

Well No. 2 Slason

Company Citites Service

Paradise Pool

NORTH

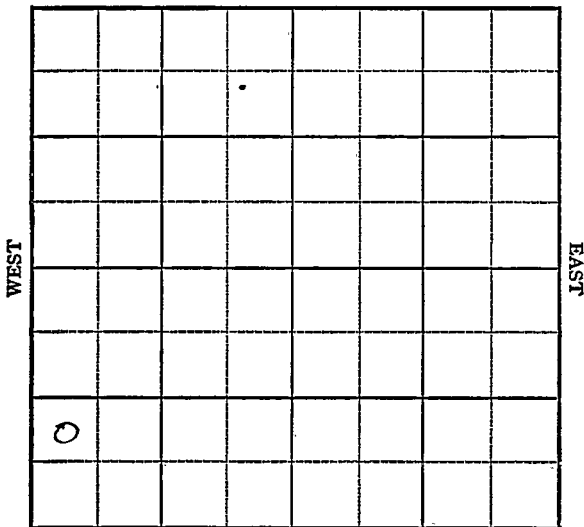

SOUTH

Sec. 27 Twp. 9 R. 18W

Well No. 2 Slason Farm


Cities Service Company
Paradise Pool

 Ft. from N. Line

990 Ft. from S. Line

 Ft. from E. Line

330 Ft. from W. Line

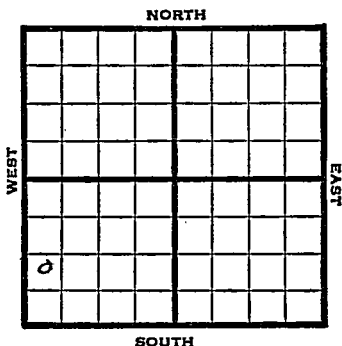

NW SW SW

1948 Eli 2152' REPORT

8/25 8" @ 318
WOC

9/1 Drlg. 3238'

9/8 Lansing 3334'
Drlg 3475'

9/15 Arb. 3610'
TD 3640'

Aband.
ABANDONED

