


Section 27 Township 9 Range 19W

Well No. #1 Bartos

Company Cities Service

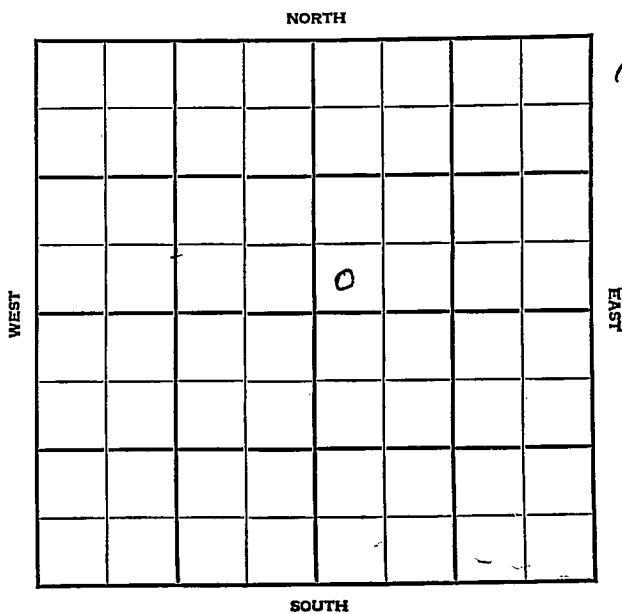

Rooks

KANSAS

Sec. 27 Twp. 9 R. 19W

Well No. #1 Bartos Farm

Cities Service Company

Zurich


 Ft. from N. Line

330 Ft. from S. Line

 Ft. from E. Line

330 Ft. from W. Line

SW NE

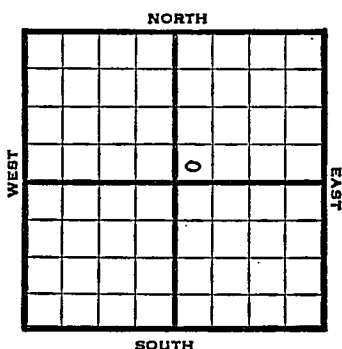

1947 Elev. 2210 R E P O R T

12/17 RUR

12/30 8" @ 204'
Arbuckle 3618-21' TD
5" @ 3619'
RUST

1948
1/7 "

1/14 "

1/21 TD 3629-500 acid
Pump 306 bbls oil 14 hrs.

1/28 Arb. 3622'
5" @ 3623'
Echo Pot 3000'
27.0 Gr.
TD 3629'
Comp.

COMPLETED

Map No. _____ Sec. 27 Twp. 9 R. 19W

Well No. 1 Bartos

_____ Cities Service _____ Company

_____ FIRST REPORT _____ Contractor

SW NE


SECTION PLAT

_____ Ft. from N. Line

330 Ft. from S. Line

_____ Ft. from E. Line

330 Ft. from W. Line

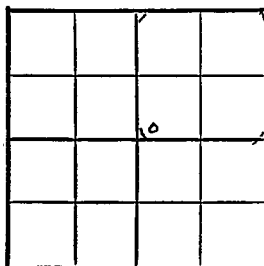

_____ Books County _____

Location _____

Rig up _____

Drilling and Remarks:

R U R

RECORD

Cased _____ in., _____ ft.

Sand _____

Gas _____

Oil _____

Total Depth _____

PRODUCTION

1st 24 hrs. Nat. _____

1st 24 hrs. after shot _____

Gas _____ Cu. Ft.

Dry Hole _____

Abandoned _____

Date

DEC 1 7 1947 19 S. J. LEWIS Scout

Map No. 65 Sec. 27 Twp. 9 R. 19W

Well No. 1 Bartos

Cities Service Company

COMPLETE Contractor

SW NE

E 12210

SECTION PLAT

		0	

 Ft. from N. Line

330 Ft. from S. Line

 Ft. from E. Line

330 Ft. from W. Line

Rooks County

Location

Rig up

Drilling and Remarks:

Cer 8622.

5" @ 8623

Ecl 12210 86000

27-9-48

RECORD

Cased in., ft.

Sand

Gas

Oil ✓

Total Depth 8628

PRODUCTION

1st 24 hrs. Nat.

1st 24 hrs. after shot

Gas Cu. Ft.

Dry Hole

Abandoned

Date

JAN 28 1948 19

S. J. LEWIS Scout