

Section 27 Township 9 Range 19W

Well No. #1 Mongean

Company Cities Service

Zurick Pool

NORTH

			0.				

WEST

EAST

SOUTH

KANSAS

Rooks

Sec. 27 Twp. 9 R. 19W

Well No. #1 Mongean Farm

Cities Service Company

Zurick Pool


_____ Ft. from N. Line

990' Ft. from S. Line

330' Ft. from E. Line

_____ Ft. from W. Line

NE SE NW

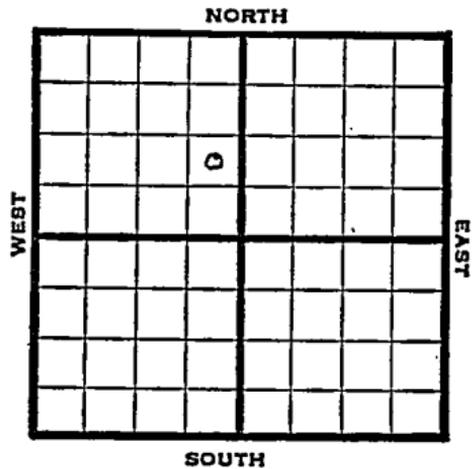

1948	Elev. 2200' R E P O R T
2/18	Location
2/25	8" @ 295'
	Drlg. 2625'
3/3	Lansing 3364'
	Arbuckle 3618'
	TD 3621'
	5" @ 3619'
	RUST
3/10	"
3/17	"
3/24	SLM 3621-17
	Lansing 3360'
	Arbuckle 3614'
	5" @ 3615'
	TD 3618'
	Pump 229 bbls oil @ 2 hrs
	500 acid
3/31	Arbuckle 3614'
	5" @ 3615'
	500 Acid
	Echo Pot 1487
	Gr. 26°
	TD 3618'
	COMPLETED

Map No. _____ Sec. 27 Twp. 9 R. 19W

Well No. 1 Mongean

Cities Service Company

FIRST REPORT

Contractor

NE SE NW


SECTION PLAT

_____ Ft. from N. Line

990 Ft. from S. Line

330 Ft. from E. Line

_____ Ft. from W. Line

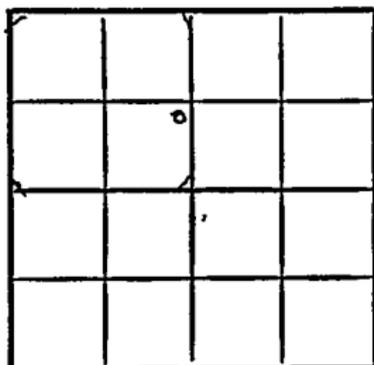

Rooks County

RECORD

Location X

Cased _____ in., _____ ft.

Rig up _____

Sand _____

Drilling and Remarks:

Gas _____

Oil _____

Total Depth _____

PRODUCTION

1st 24 hrs. Nat. _____

1st 24 hrs. after shot _____

Gas _____ Cu. Ft.

Dry Hole _____

Abandoned _____

Date

FEB 18 1948

19

S. J. LEWIS

Scout

