

Section 27 Township 9 Range 19W

Well No. 3 Siker

Company Cities Service  
Ghandler

NORTH


WEST

EAST

SOUTH

10



Sec. 27 Twp. 9 R. 19W

Well No. #3 Siker Farm \_\_\_\_\_

Cities Service Company

Chandler Pool


990' Ft. from N. Line

\_\_\_\_\_ Ft. from S. Line

\_\_\_\_\_ Ft. from E. Line

660' Ft. from W. Line

C S L NWSE

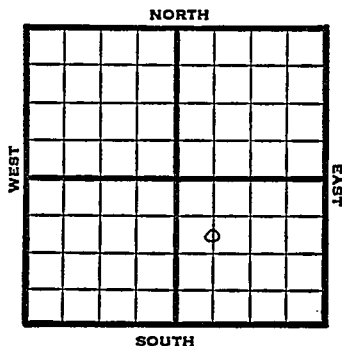

1949

Eli 2002'

REPORT

1/5

8" @ 289'  
Drlg. 900'

1/12

Lansing 3390 RecArbuckle 3618  
Drlg 3685

1/19

TD 3701'  
Arb. 3686'  
Aband.

**ABANDONED**

Kansas

Map No. \_\_\_\_\_ Sec. 27 Twp. 9 R. 19WWell No. 3 Siker

\_\_\_\_\_ Cities Service \_\_\_\_\_ Company

\_\_\_\_\_ **FIRST REPORT** \_\_\_\_\_ Contractor

C S L NW SE

**SECTION PLAT**990 Ft. from N. Line

\_\_\_\_\_ Ft. from S. Line

\_\_\_\_\_ Ft. from E. Line

660 Ft. from W. Line


Rooks County

Location \_\_\_\_\_

Rig up \_\_\_\_\_

Drilling and Remarks:

8" @ 289

drlg. 900

**RECORD**

Cased \_\_\_\_\_ in., \_\_\_\_\_ ft.

Sand \_\_\_\_\_

Gas \_\_\_\_\_

Oil \_\_\_\_\_

Total Depth \_\_\_\_\_

**PRODUCTION**

1st 24 hrs. Nat. \_\_\_\_\_

1st 24 hrs. after shot \_\_\_\_\_

Gas \_\_\_\_\_ Cu. Ft.

Dry Hole \_\_\_\_\_

Abandoned \_\_\_\_\_

Date

JAN 5 1949S. J. LEWIS Scout

Kansas

Map No. 65 Sec. 27 Twp. 9 R. 19W

Well No. 3 Sikes

Cities Service Company

**ABANDONED**

Contractor

C § L NW SE

*E 12002*  
SECTION PLAT

990 Ft. from N. Line

         Ft. from S. Line

         Ft. from E. Line

660 Ft. from W. Line


Rooks County

**RECORD**

Location \_\_\_\_\_

Cased \_\_\_\_\_ in. \_\_\_\_\_ ft.

Rig up \_\_\_\_\_

Sand \_\_\_\_\_

Drilling and Remarks:

Gas \_\_\_\_\_

*On 89686*

Oil \_\_\_\_\_

Total Depth 221

**PRODUCTION**

1st 24 hrs. Nat. \_\_\_\_\_

1st 24 hrs. after shot \_\_\_\_\_

Gas \_\_\_\_\_ Cu. Ft.

Dry Hole \_\_\_\_\_

Abandoned \_\_\_\_\_

Date

JAN 1 9 1949

19

S. J. LEWIS Scout