


Section 27 Township 9 Range 20WWell No. 10 HinkhouseCompany Nadel & Gussman

Hampton

NORTH

WEST

EAST

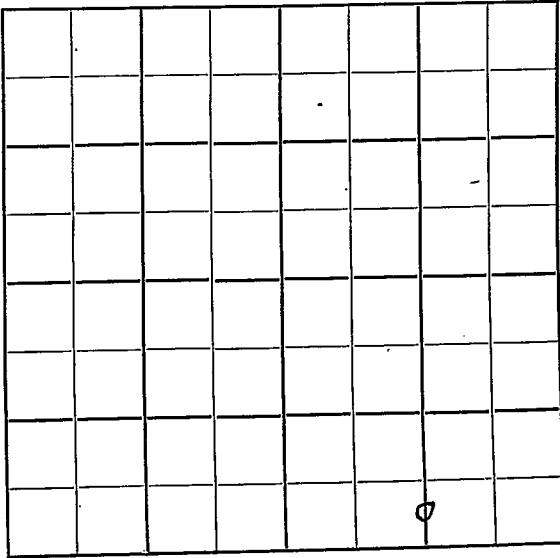

SOUTH

16

D

KANSAS

Rooks

Sec. 27 Twp. 9 R. 20W

Well No. #10 Hinkhouse Farm
Nadel & Gussman Company

Hampton Pool

 Ft. from N. Line

330'


 Ft. from S. Line

1320'

 Ft. from E. Line

 Ft. from W. Line

C S L SE

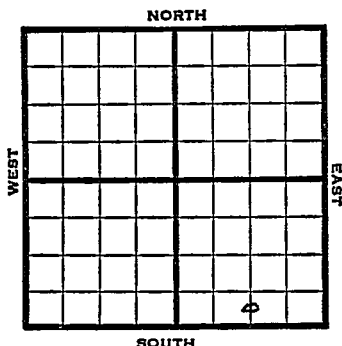

1949

Elev. 2278' REPORT

4/27

8" @ 132'

Anhy 1757'

Drlg. 2510'

5/4

Drlg 3750'

5/10

Lansing 3539'

Simpson 3817'

Arbuckl 3831-33'

TD 3833'

5" @ 3831'

5/18

"

5/25

TD 3836

1000 acid

Swb 3 1/4 bbls oil PH

6/1

"

6/7

"

6/15

"

6/22

Arb. 3831'

5" @ 3831'

1000 acid

Pump 120 oil Pot.

Gr. 27°

TD 3836'

COMPLETED

Kansas

Map No. _____ Sec. 27 Twp. 9 R. 20WWell No. 10 HinkhouseNadel & Gussman


Company

FIRST REPORT

Contractor

C S L SE

SECTION PLAT

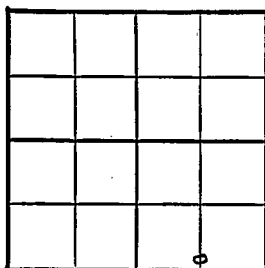

_____ Ft. from N. Line

330 Ft. from S. Line1320 Ft. from E. Line

_____ Ft. from W. Line

Rooks County

Location _____

Rig up _____

Drilling and Remarks:

8" @ 132

Anhy 1757

dr1g. 2510

RECORD

Cased _____ in., _____ ft.

Sand _____

Gas _____

Oil _____

Total Depth _____

PRODUCTION

1st 24 hrs. Nat. _____

1st 24 hrs. after shot _____

Gas _____ Cu. Ft.

Dry Hole _____

Abandoned _____

Date

APR 27 1949

19

S. J. LEWIS

Scout

Kansas
 Map No. K65 Sec. 27 Twp. 9 R. 20W

Well No. 10 Hinkhouse

Nadel & Gussman Company

COMPLETE Contractor

C S L SE


21,2278
SECTION FLAT

 Ft. from N. Line

330 Ft. from S. Line

1320 Ft. from E. Line

 Ft. from W. Line

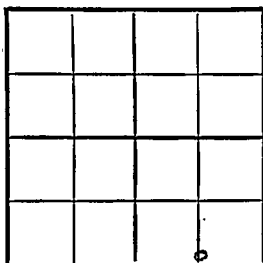

Rooks County

Location

Rig up

Drilling and Remarks:

Cr 43831

5" C 3831

10000 ac

Pump 120 oil P28

2734

RECORD

Cased in., ft.

Sand

Gas

Oil

Total Depth 2736

PRODUCTION

1st 24 hrs. Nat.

1st 24 hrs. after shot

Gas Cu. Ft.

Dry Hole

Abandoned

Date

JUN 22 1949 19 S. J. LEWIS Scout