

KANSAS

Rooks


Section 27 Township 9 Range 20W

Well No. 11 Hinkhouse

Company Nadel & Gussman

Palco

NORTH

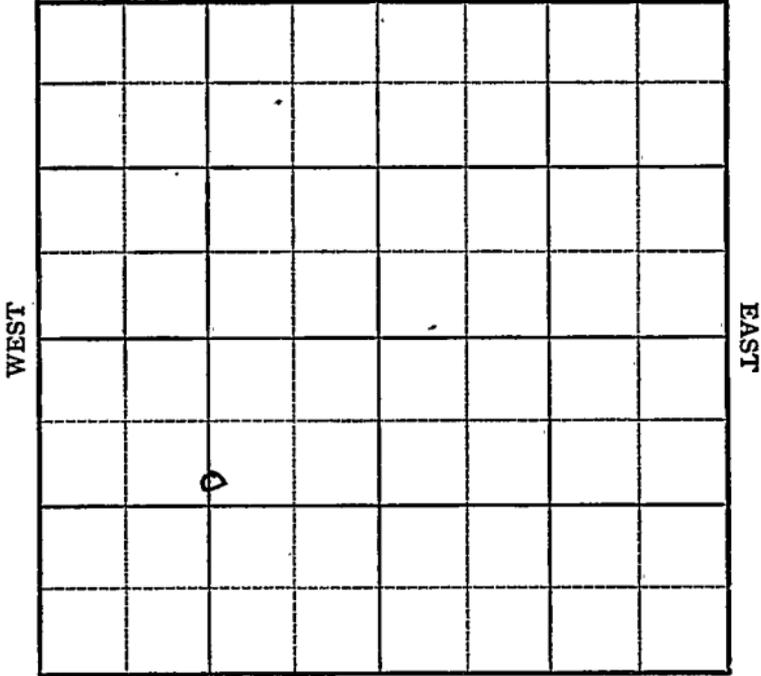

SOUTH

11

KANSAS Rooks

Sec. 27 Twp. 9 R. 20W ✓

Well No. #11 Hinkhouse Farm

Nadel & Gussman

Company

Palco Pool (Reserve Drlg., Cont.)

NORTH


990' Ft. from N. Line

_____ Ft. from S. Line

1320' Ft. from E. Line

_____ Ft. from W. Line

C S L N $\frac{1}{2}$ SW

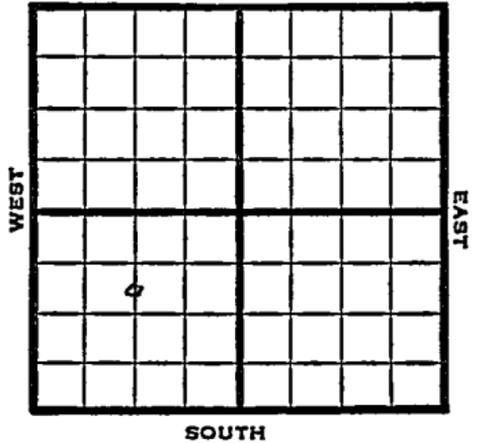

1949

Elev. 2278' REPORT

5/25

Location

6/1

8" @ 127'

Drlg 3215'

6/7

Lansing 3524'

Simpson 3800'

Arbuckle 3821'

TD 3823'

5" @ 3821'

6/15

"

6/21

TD 3825'

1000 acid

Swb 85 bbls oil 1 hr

6/28

"

7/6

Arb 3821'

5" @ 3821'

1000 acid

Echo Pot. 3000

TD 3825'

Gr. 27°

COMPLETED

Map No. _____ Sec. 27 Twp. 9 R. 20W

Well No. 11 Hinkhouse

Nadel & Gussman Company

Reserve Drlg. Contractor

C S L N $\frac{1}{2}$ SW

**FIRST REPORT
SECTION PLAT**

990 Ft. from N. Line

_____ Ft. from S. Line

1320 Ft. from E. Line

_____ Ft. from W. Line

Rooks County

Location X

Rig up _____

Drilling and Remarks:

RECORD

Cased _____ in., _____ ft.

Sand _____

Gas _____

Oil _____

Total Depth _____

PRODUCTION

1st 24 hrs. Nat. _____

1st 24 hrs. after shot _____

Gas _____ Cu. Ft.

Dry Hole _____

Abandoned _____

Date

MAY 25 1949 19

S. J. LEWIS

Scout


Kansas

Palco Pool

Map No. K65 Sec. 27 Twp. 9 R. 20WWell No. 11 HinkhouseNadel & Gussman Company**COMPLETE**

Contractor

C S L SE SW

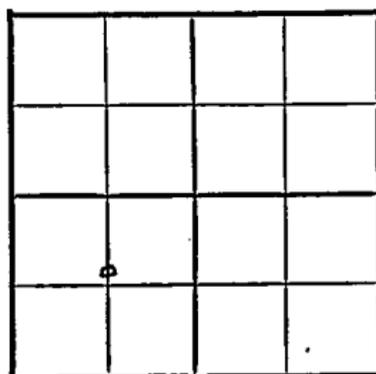E12278
SECTION PLAT980 Ft. from N. Line

_____ Ft. from S. Line

1320 Ft. from E. Line

_____ Ft. from W. Line

Rooks County

Location _____

Rig up _____

Drilling and Remarks:

Per 38215" @ 38211000 acidEch to Per 300027 @ 3821

RECORD

Cased _____ in., _____ ft.

Sand _____

Gas _____

Oil _____

Total Depth 19257.11.41 PRODUCTION

1st 24 hrs. Nat. _____

1st 24 hrs. after shot _____

Gas _____ Cu. Ft.

Dry Hole _____

Abandoned _____

Date

JUL 6 1949 19

S. J. LEWIS

Scout