

Sec. 27 Twp. 9 R. 20W ✓

Well No. #17 Hinkhouse Farm

Nadel & Gussman Company

Contractor

North Hampton Pool


990' Ft. from N. Line

_____ Ft. from S. Line

_____ Ft. from E. Line

330' Ft. from W. Line

SW NW SW

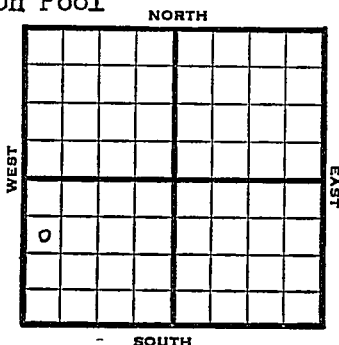

1950

Elev. 2252'

REPORT

12/6 Spud 12-4-50

1951
2/21 Spud 12-4-50

Oil well

9-5/8" @163

Toronto 3496

5" @3809

12/ 3787-3800

6/ 3795-97

FU 1200' oil 12 hr.

500 A

Comp. 105 bopd

TD 3810

Anhy 1782

Lans. 3504

TD 3810

12/ 3793-95

6/ 3797-3800

Heeb. 3473

Arb. 3793

SP 3807

S/ 35 boph

COMPLETED

