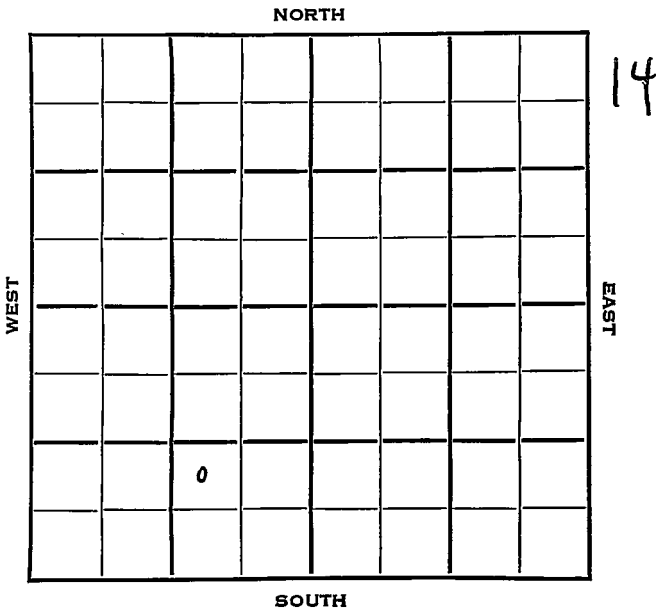


Section 27 Township 9 Range 20WWell No. #19 HinkhouseCompany Nadel & Gussman

Rooks KANSAS

SEC.	TWP.	R.
27	9	20W ✓
WELL NO.		
19 Hinkhouse		FARM
COMPANY		
Nadel & Gussman		
CONTRACTOR		

Reserve Drlg.

N. Hampton Pool

_____ Ft. from N. Line

990


_____ Ft. from S. Line

990

_____ Ft. from E. Line

_____ Ft. from W. Line

NW SE SW

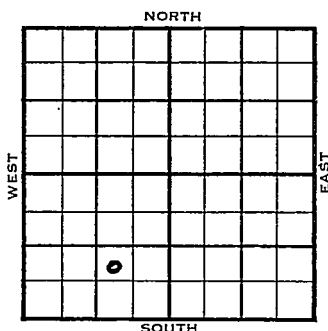

1954

ELEVATION

2266'

REPORT

3/10

Spud 3-4-54

10" @ 164'

Drlg. 2555'

3/17

KC 3510'

DST 3585-95, 3/4 hr, 210' gas, 440' oil, 90' OCM Cong. 3756

Drlg. 3785'

3/24

Simp Shale 3803 Arb. 3809

RTD 3812' 7" @ 3811

3/31

24/3596-3600 S/6 BOPH 2 hrs.

S/2 1/2 BOPH 1 hr. 500 A FU 1261' oil

4/28

Spud 3-4-54

Oil Well

TB 3812'

10" @ 164'

KC 3510'

DST 3585-95', opn 3/4 hrs., rec. 210' gas, 440' oil, 90' ocm,

Cong 3756', Simp. 3803', Arb. 3809'

TD 3812'

7" @ 3811',

24. 3596-3600, S/6 boph 2 hrs.

S/2 1/2 boph 1 hr., 500A, FU 126' oil

Comp. 454 bopd


J. G. McGEHEE

County _____ Rooks _____ State Kansas
 Sec. 27 (Blk.) 9 (Sur.) 20W Map No. _____
 (Twp.) _____ (Rge.) _____

Operator Nadel & Gussman

Well No. 19 Farm Hinkhouse

Elev. 2266 Location NW SE SW

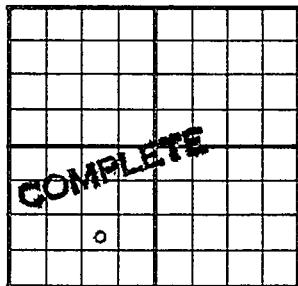

990 Ft. From S Line SW

990 Ft. From E Line Quarter

1st. Report _____

Completion APR 28 1954

Remarks N. Hampton Pool

Reserve Drlg. - Contr.

Spudding Date 3-4-54

Drlg. Data Oil well TD 3812

10" @ 164 KC 3510 DST 3585-95

open 3/4 hr. Rec. 210' gas 440' oil

90' ocm Cong. 3756 Simp. 3803

Arb. 3809 TD 3812 7" @ 3811 24. 3596-

3600 S/ 6 boph 2 hr. S/ 2 1/2 boph

1 hr. 500 A FU 126' oil

Comp. 454 bopd

J. G. McGEHEE