



KANSAS

Sec. 27 Twp. _____ R. 20W

Well No. #5 Tribble Farm _____

D. G. Hansen Company _____

North Hampton


990' Ft. from N. Line

_____ Ft. from S. Line

330' Ft. from E. Line

_____ Ft. from W. Line

SE NE NW

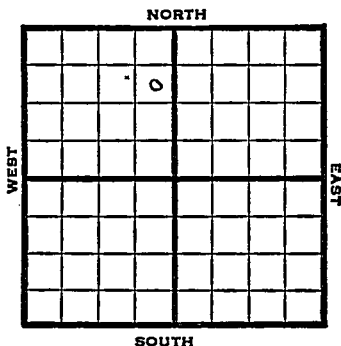

1948

Eli 2246' REPORT

10/20

8" @ 168'

10/26

Drilg 3224'

11/3

"

11/10

TD 3919 In cong.

Cong 3821'

Aband.

ABANDONED

Map No. _____ Sec. 27 Twp. 9 R. 20W

Well No. 5 Tribble

D. G. Hansen Company

FIRST REPORT Contractor

SE NE NW


SECTION PLAT

990 Ft. from N. Line

_____ Ft. from S. Line

330 Ft. from E. Line

_____ Ft. from W. Line

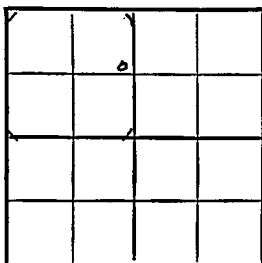

Rooks County

Location: _____

Rig up _____

Drilling and Remarks:

8" @ 168

RECORD

Cased _____ in., _____ ft.

Sand _____

Gas _____

Oil _____

Total Depth _____

PRODUCTION

1st 24 hrs. Nat. _____

1st 24 hrs. after shot _____

Gas _____ Cu. Ft.

Dry Hole _____

Abandoned _____

Date

OCT 20 1948 19

S. J. LEWIS

Scout

Kansas

Map No. 65 Sec. 27 Twp. 9 R. 20WWell No. 5 TribbleD. G. Hansen Company**ABANDONED**

Contractor

SE NE NW

E1, 2246
SECTION PLAT990 Ft. from N. Line Ft. from S. Line330 Ft. from E. Line Ft. from W. Line

| | | | |
|--|---|--|--|
| | | | |
| | 6 | | |
| | | | |
| | | | |
| | | | |

Rooks County

Location Rig up

Drilling and Remarks:

Comp 8821

RECORD

Cased in., ft.Sand Gas Oil Total Depth 2919 in. Comp

PRODUCTION

1st 24 hrs. Nat. 1st 24 hrs. after shot Gas Cu. Ft.Dry Hole Abandoned

Date

NOV 10 1948 19

S. J. LEWIS Scout