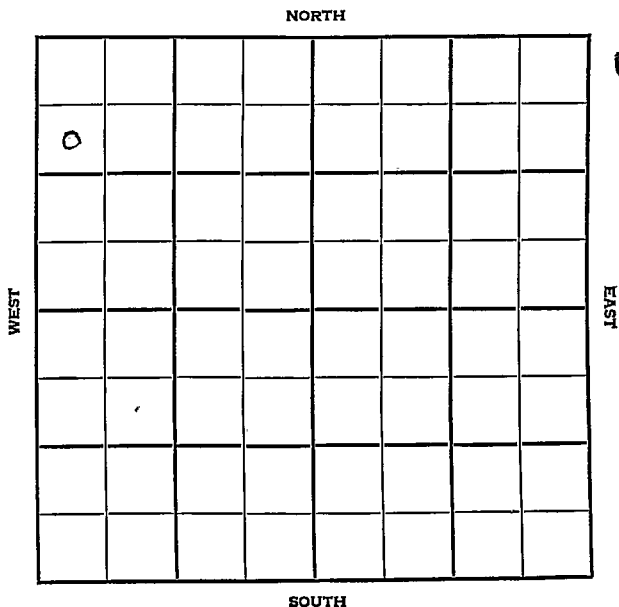


Section 27 Township 9 Range 20 WWell No. #6 TribbleCompany D. G. Hansen

Rooks

KANSAS

SEC.	TWP.	R.
27	- 9	20N

WELL NO.

#6 Tribble

FARM

COMPANY

D.G. Hansen

CONTRACTOR

C. & G

Northampton

NORTH

Ft. from N. Line

Ft. from S. Line

Ft. from E. Line

Ft. from W. Line

0							

WEST

EAST

SOUTH

SW NW NW

	ELEVATION	REPORT
1955	2236'	

9-14- Comm. 9-12-55
8" @ 163/140

12-7 5½" @ 3798
DD 3801
S/ 2 boph, 80% wtr., 500 A
P/ 4 BO, 4 BWPH
Comp. 84 BOPD, 26% wtr.
Anh. 1726
Tp. 3260
H. 3463
Tr. 3484
KC 3504
BKG 3723
C. 3762
A. 3797
TD 3800'

COMPLETED

County

Rooks

Elev.

Sec.

27

Twp.

9

Rgs.

20W

Company

D. G. Hansen

FarmName

Tribble

No.

6

TOPS

DEPTH

LOG

DATUM

Loc. in Sec.

Anh.

Tp.

H.

Tr.

Dg.

Bl.

L.

K.C.

B.K.C.

Ce.

C.

M.

M.

K.

Mz.

Mq.

V.

S.

S.

A.

R.

P.E.

G.

T.D.

SW NW NW

Geol.

Contr.

C. & G

Pool

Northampton

FIRST REPORT

SEP 14 '55

Date Comm.

9-12-55

8th @ 163/110

Co.

Lse.

No.

Sec.

T.

R.

County Hooks Elev. 2236
 Sec. 27 Rge. 20W
 Company D. C. Hansen
 Farm Name Tribble No. 6

TOPS	DEPTH	LOG	DATUM	Loc. in Sec.
Anh.	172.6			SW NW NW
Tp.	32.60		1024	
H.	34.63		1227	
Tr.	34.84		1248	
Dg.				
Bl.				
L.				
K.C.	3504		12108	Geol.
B.K.C.	3723		1487	Contr.
Ce.				
C.	3762		1526	C & G Drlg.
M.				
M.				Pool
K.				
Mz.				Northampton
Me.				
V.				
S.				
S.				
A.	3797		1561	COMPLETED
R.				
Pe.				
G.				
T.D.	3800			

Date Comm. 9-12-55 DEC 7 1955

8" @ 163/140 5 $\frac{1}{2}$ " @ 3798 DD 3801

S/ 2 boph 80% wtr. 500 A

P/ 4 bo 4 bwph Comp. 84 bopd 26% wtr.