
KANSAS Graham

FORM 51 10M 8-47

Section 27 Township 9 Range 21W

Well No. 1 Teall

Company ~~Anderson-Prichard~~

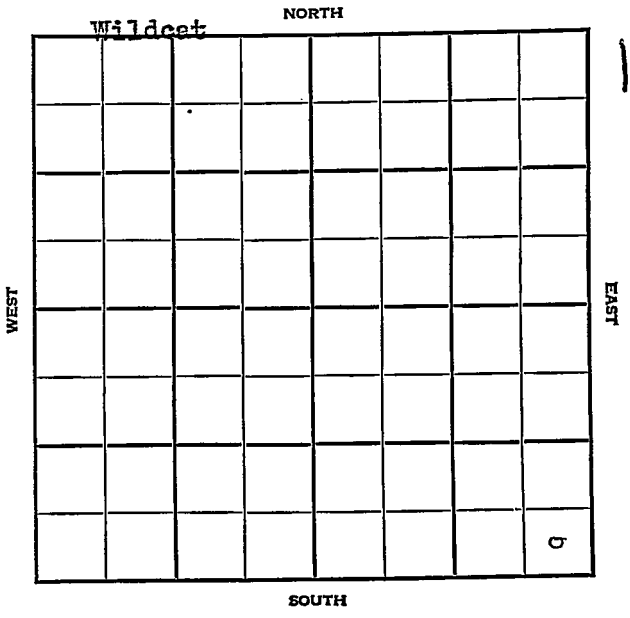

FORM 252-A
5M 9-47 PETROL


Graham

Sec. 27 Twp. KANSAS 9 R. 21W

Well No. #1 Teall Farm

Anderson-Prichard Company

Wildcat

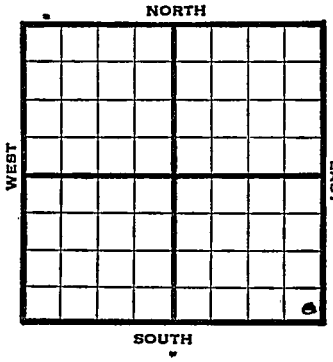

330 Ft. from N. Line

330 Ft. from S. Line

Ft. from E. Line

Ft. from W. Line

SE/C

1947	Elev. 2308' REPORT
10/8	Location
10/15	10" @ 220' Drlg. 1460'
10/22	Drlg. 3773'
10/29	Lansing 3556' Arbuckle 3962' TD 3983'
	ABANDONED

Form 26 200 Bks. 10-46 Petrol

Kansas

Wildcat

Map No. _____ Sec. 27 Twp. 9 R. 21W


Well No. 1 Teall

Anderson-Prichard Company

FIRST REPORT Contractor

SE/C

SECTION PLAT

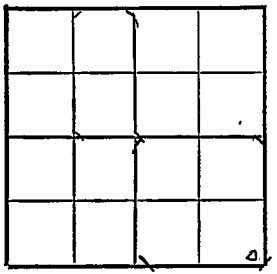

_____ Ft. from N. Line

330 Ft. from S. Line

330 Ft. from E. Line

_____ Ft. from W. Line

Graham County

Location X

Rig up

Drilling and Remarks:

RECORD

Cased _____ in., _____ ft.

Sand

Gas

Oil

Total Depth

PRODUCTION

1st 24 hrs.

1st 24 hrs. after shot

Gas _____ Cu. Ft.

Dry Hole

Abandoned

Date

OCT 8 1947 19

S. J. LEWIS Scout

Form 26 200 Bks. 10-46 Petrol

Wildcat

Kansas

Map No. 65 Sec. 27 Twp. 9 R. 21W

Well No. 1 Teall


Anderson-Prichard Company

ABANDONED Contractor

SE/C

E 1.2308'

SECTION PLAT

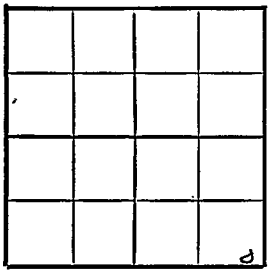

____ Ft. from N. Line

330 Ft. from S. Line

330 Ft. from E. Line

____ Ft. from W. Line

Graham County

Location

Rig up

Drilling and Remarks:

Loan 3856

Cer #8962

RECORD

Cased ____ in., ____ ft.

Sand

Gas

Oil

Total Depth 3983

PRODUCTION

1st 24 hrs. Nat.

1st 24 hrs. after shot

Gas ____ Cu. Ft.

Dry Hole

Abandoned

Date

OCT 29 1947 19

S. J. LEWIS Scout