

~~KANSAS~~


Graham

FORM 51 5M 11-44 PETROL

Section 27 Township 9 Range 21-W

Well No. #1 Miller

Company Derby et al

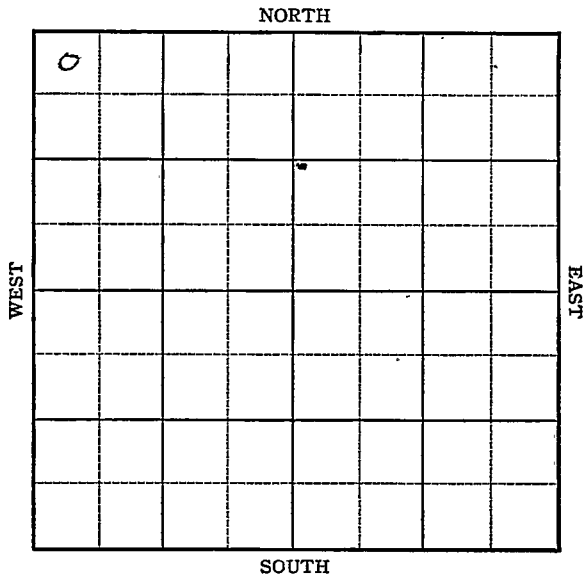

KANSAS

Graham County

Sec. 27 Twp. 9 R. 21W

Well No. #1 Miller Farm

Derby et al Company

Morel


330 Ft. from N. Line

 Ft. from S. Line

 Ft. from E. Line

330 Ft. from W. Line

NW/c

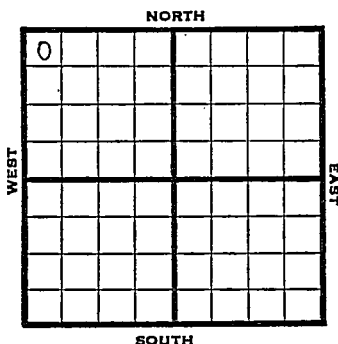

1946

Elev. 2292'

R E P O R T

1/9

8" @ 268

Anhy. 1715

Drig. 2725'

1/17

Lans. 3494' BKC 3740'

Arb 3830-37' T.D. Sat.

1/24

5" - 3833' RUST.

1/31

" " "

2/7

" " "

2/14

" " "

2/20

Arb. 3830

5" @ 3833

TD 3843'

ABANDONED

KANSAS

Pool Name MorelMap No. 2 Sec. 27 Twp. 9 R. 21WWell No. 1 MillerDerby etal

Company

FIRST REPORT

Contractor


NW/c

SECTION PLAT

330 Ft. from N. Line

Ft. from S. Line

Ft. from E. Line

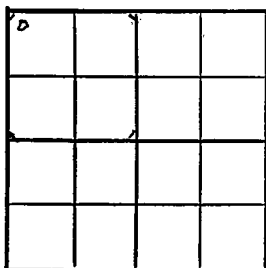330 Ft. from W. LineGraham County

Location

Rig up

Drilling and Remarks:

8"-268

Anhy 1715
2725

RECORD

Cased _____ in, _____ ft.

Sand _____

Gas _____

Oil _____

Total Depth _____

PRODUCTION

1st 24 hrs. Nat. _____

1st 24 hrs. after shot _____

Gas _____ Cu. Ft.

Dry Hole _____

Abandoned _____

Date

JAN 9 1919

S. J. LEWIS Scout

KANSASKansas Pool Name MorelMap No. 65 Sec. 27 Twp. 9 R. 21WWell No. 1 MillerDerby etal

Company

ABANDONED

Contractor

NW/c

E12292
SECTION PLAT330 Ft. from N. Line

Ft. from S. Line

Ft. from E. Line

330

Ft. from W. Line

Graham County

0			

Location

Rig up

Drilling and Remarks:

CR 38305" C 3833**RECORD**

Cased _____ in., _____ ft.

Sand _____

Gas _____

Oil _____

Total Depth 3842**PRODUCTION**

1st 24 hrs. Nat. _____

1st 24 hrs. after shot _____

Gas _____ Cu. Ft.

Dry Hole _____

Abandoned _____

Date

FEB 20 1946

19

S. J. LEWIS

Scout