Graham KANSAS

27 9S 22W

SECTION TOWNSHIP RANGE

#1 Barber


WELL NO.

Brown & Fortier

COMPANY

SW SE NE

8

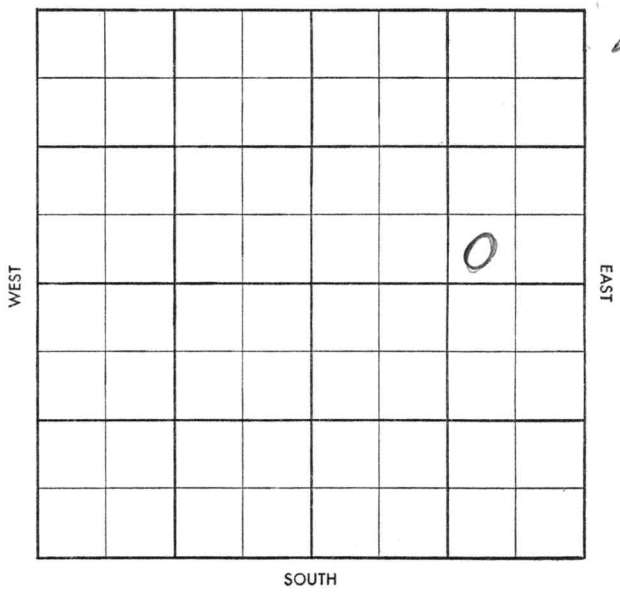

FORM 504-3 SUNRAY

Red line

5

S-513-A

CO. Graham ELEV.

SEC. 27 TWP. 9 RGE. 22W

COMPANY Brown & Fortier NO. 1

FARM Barber

LOC. SW SE NE

FIRST REPORT

OCT 30 '57

GEOL. Gene Taylor

CONTR. Burch Drlg. tools

POOL Ironclad

SPUD 10-26-57

8" @ 194 w/150, Drlg. 3000

CO.

LSE.

NO.

SEC.

TWP.

RGE.

~~RED LINE~~

S-513-A

CO. Graham ELEV. _____

SEC. 27 TWP. 9 RGE. 22W

COMPANY ~~Brown & Fortier~~ NO. 1

ABANDONED

NOV 6 '57

FARM Barber

LOC. SW SE NE

GEOL. Gene Taylor

CONTR. Burch Drlg. tools

POOL Ironclad

SPUD 10-26-57

3583

2353

1232

2353

1220

533

8" - 194 w/150, Drlg. 3000 NOV 6 57

A 1820 Hb 3547 TR 3570

Lsg 3585 DST 3719-3735

30" 9' BHP 318 BKC 3812

RTD 3815 no log

D & A

CO.

LSE.

NO.

SEC.

TWP.

RGE.