
FORM 51 25M 8-50 WESTERN Graham KANSAS

Section 27 Township 9 Range 22W

Well No. #1 Sandlain

Company Victoria Drlg. & Deep Rock

16

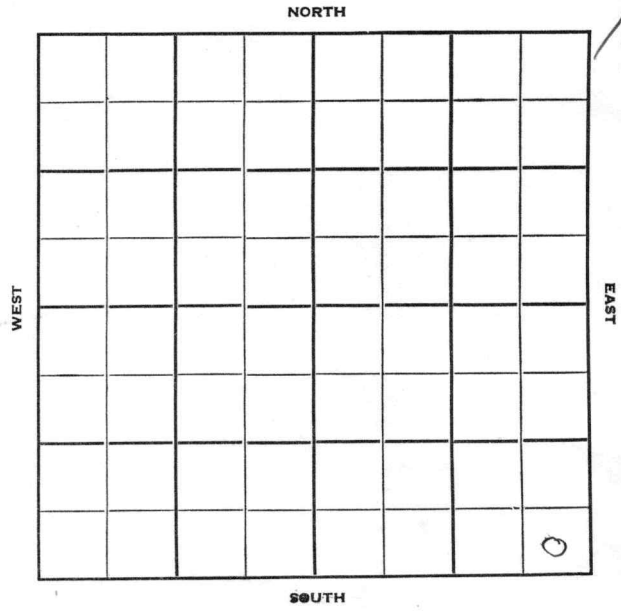

FORM 252-B
10M 10-50 PETROL

Graham KANSAS

Sec. 27 Twp. 9 R. 22 W

Well No. # 1 Sandlain Farm

Victor Drlg & Deep Rock Company

Contractor


Ft. from N. Line

330 Ft. from S. Line

330 Ft. from E. Line

Ft. from W. Line

SE SE SE

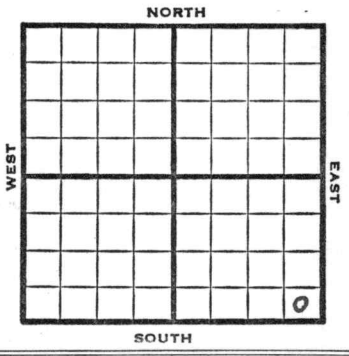

1952	Elev. 2379 REPORT
8/6	Location
8/13	8" @ 183'
	Anhy 1850'
	Drlg. 2950'
8/20	Spud 8-7-52 D&A TD 4035
	8" @ 183 Anhy 1850 Heeb. 3569
	Tor. 3592 Lans. 3604
	DST 3788-3820 opn 1hr. Rec.185' wtr.
	1100# BKC 3816 Cong. 3985
	Arb. 3989 TD 4035 D&A
	ABANDONED

FORM 275 FOR SALE BY KANSAS BLUE PRINT CO.

County Graham State Kansas

Sec. 27 (Blk. Twp.) 9 (Sur. Rge.) 22W Map No.

Operator Victor Drlg. & Deep Rock

Well No. 1 Farm Sandlain

Elev. Location SE SE SE



330 Ft. From S Line SE

330 Ft. From E Line Quarter

1st. Report AUG 6 1952

Completion

Remarks

Spudding Date

Drlg. Data

Location

J. G. McGEHEE

FORM 275 FOR SALE BY KANSAS BLUE PRINT CO.


County Graham State Kansas

Sec. 27 (Blk. Twp.) 9 (Sur. Rge.) 22W Map No.

Operator Victor Drlg. & Deep Rock

Well No. 1 Farm Sandlain

Elev. 2379 Location SE SE SE

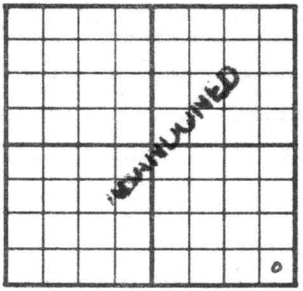

330 Ft. From S Line SE

330 Ft. From E Line Quarter

1st. Report

Completion AUG 2 0 1952

Remarks

Spudding Date 8-7-52

Drlg. Data D & A TD 4035

8" @ 183 Anhy 1850 Heeb. 3569

Tor. 3592 Lans. 3604 DST 3788-3820

open 1 hr. Rec. 185' water 1100#

B KC 3816 Cong. 3985 Arb. 3989

TD 4035

D & A

J. G. McGEHEE