5-9s-27W
NE SW SE

RECEIVED
NOV 28 1983
State Geological Survey
WICHITA BRANCH

TYPE
SIDE ONE

AFFIDAVIT OF COMPLETION FORM

ACO-1 WELL HISTORY

Compt. ____ INJ ____ PI

DOCKET NO. NP ____

(Rules 82-3-130 and 82-3-107)
This form shall be filed with the Kansas Corporation Commission, 200 Colorado Derby Building, Wichita, Kansas 67202, within ninety (90) days after the completion of a well, regardless of how the well was completed.

FOR INFORMATION REGARDING THE NUMBER OF COPIES TO BE FILED AND APPLICATIONS REQUIRING COPIES OF ACO-1 FORMS SEE PAGE TWO (2), SIDE TWO (2) OF THIS FORM.

F ____ Letter requesting confidentiality attached.

C / Attach ONE COPY of EACH wireline log run (i.e. electrical log, sonic log, gamma ray neutron log etc.)***Check here if NO logs were run ____.

PLEASE FILL IN ALL INFORMATION. IF NOT AVAILABLE, INDICATE. IF INFORMATION LATER BECOMES AVAILABLE, SUBMIT BY LETTER.

LICENSE # 6066 EXPIRATION DATE 6/30/84

OPERATOR Skyline Petroleum API NO. 15 - 179 - 20,708

ADDRESS P. O. Box 70 COUNTY Sheridan

Hays, Kansas 67601 FIELD ____

** CONTACT PERSON Daniel Shippers PROD. FORMATION ____

PHONE 913-735-2257 ____ Indicate if new pay.

PURCHASER ____ LEASE Kennedy

ADDRESS ____ WELL NO. #1

____ WELL LOCATION NE SW SE

DRILLING CONTRACTOR Big Springs Drilling, Inc. 990 Ft. from South Line and


ADDRESS P. O. Box 8287 - Munger Station 1650 Ft. from East Line of

Wichita, Kansas 67208 the SE (Qtr.) SEC 5 TWP 9S RGE 27W (E) (W).

PLUGGING CONTRACTOR Sun Oilwell Cementing

ADDRESS Great Bend, Kansas 67530

WELL PLAT

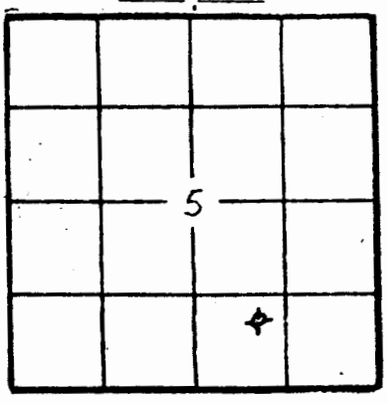

(Office Use Only)
KCC ____
KGS /
SWD/REP ____
PLG. ____
NGPA ____

TOTAL DEPTH 4100' PBTD ____

SPUD DATE 11-2-83 DATE COMPLETED 11-8-83

ELEV: GR 2663' DF ____ KB 2668'

DRILLED WITH (CABLE) (ROTARY) (AIR) TOOLS.

DOCKET NO. OF DISPOSAL OR REPRESSURING WELL BEING USED TO DISPOSE OF WATER FROM THIS LEASE ____.

Amount of surface pipe set and cemented 260' DV Tool Used? ____.

TYPE OF COMPLETION THIS AFFIDAVIT APPLIES TO: (Circle ONE) - Oil, Shut-in Gas, Gas, (Dry), Disposal, Injection, Temporarily Abandoned. If OWWO, indicate type of re-completion ____. Other completion ____. NGPA filing ____.

ALL REQUIREMENTS OF THE STATUTES, RULES AND REGULATIONS PROMULGATED TO REGULATE THE OIL AND GAS INDUSTRY HAVE BEEN FULLY COMPLIED WITH.

A F F I D A V I T

Daniel F. Schippers, being of lawful age, hereby certifies that:

I am the Affiant, and I am familiar with the contents of the foregoing Affidavit.

69028

ACO-1 Well History

(E)

Side TWO
OPERATOR Skyline Petroleum LEASE NAME Kennedy SEC 5 TWP 9S RGE 27W (W)

WELL NO #1

FILL IN WELL INFORMATION AS REQUIRED:

Show all important zones of porosity and contents thereof; cored intervals, and all drill-stem tests, including depth interval tested, cushion used, time tool open, flowing and shut-in pressures, and recoveries.

Show Geological markers, logs run, or other Descriptive information.

Formation description, contents, etc.	Top	Bottom	Name	Depth
✓ Check if no Drill Stem Tests Run.				
Check if samples sent Geological Survey.				
DRILLERS LOG				
Surface	0	260'		
Shale & Sand	260'	1945'		
Sand	1945'	2297'		
Anhydrite	2297'	2334'		
Shale	2334'	2520'		
Shale & Lime	2520'	4100'		
RTD	4100'			

If additional space is needed use Page 2

Report of all strings set — surface, intermediate, production, etc. CASING RECORD (New) or (Used)

Purpose of string	Size hole drilled	Size casing set (in O.D.)	Weight lbs/ft.	Setting depth	Type cement	Sacks	Type and percent additives
Surface	12 1/4"	8 5/8"	20#	260'	Common	175 SX	2% gel 3% ccl

LINER RECORD			PERFORATION RECORD		
Top, ft.	Bottom, ft.	Sacks cement	Shots per ft.	Size & type	Depth interval

TUBING RECORD					
Size	Setting depth	Packer set at			