


A Ottawa

Section 28 Township 9 Range 1W

Well No. #1 Carthier *EI 1397*

Company Phillips

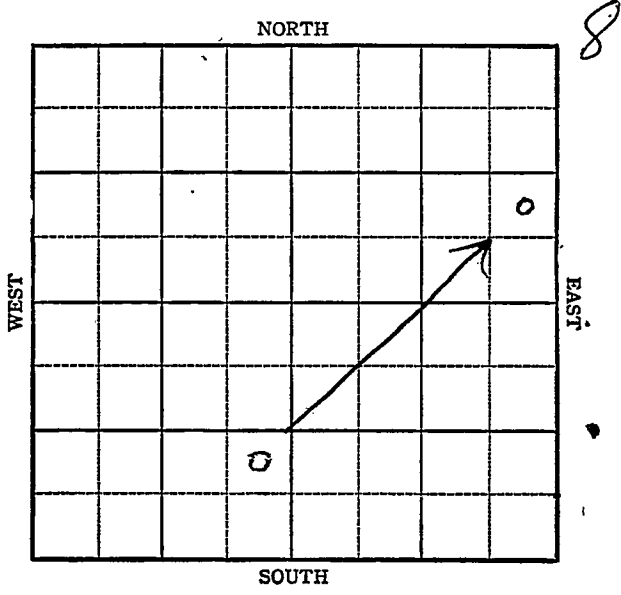

Ottawa


Sec. 28 **KANSAS** Twp. 9 R. 1W

Well No. #1 Carthier Farm

Phillips Company

wildcat

NORTH

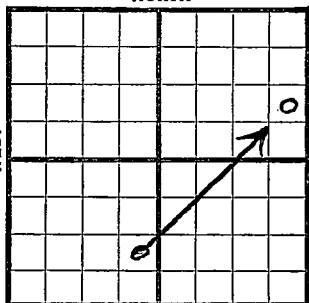

_____ Ft. from N. Line

990 _____ Ft. from S. Line

330 _____ Ft. from E. Line

_____ Ft. from W. Line

SOUTH
NESENE

1944 E1 1397 REPORT

7/26 Location

8/2 "

8/9 "

8/16 "

8/23 "

8/30 "

9/8 8" @ 320 Drlg. 1870

9/13 " " " " "

9/21 Drlg. 3560

9/27 Lans 2038

Miss 2645

Kind 2828

Hunton 2962

Viola 3326

Simp 3448

Arb 3560

TD 3596

10

3448
2962

486

ABANDONED

Lan - 641 ✓

Miss - 1248

Kind. - 1431

Hunton - 1565

Viola - 1929

Simp - 2051

Arb - 2163

T.D - 2199

Pool Name Wildcat

Map No. KANSAS Sec. 28 Twp. 9 R. 1W

Well No. 1 Carthier

Phillips Company

FIRST REPORT Contractor

NE SE SW

SECTION PLAT

_____ Ft. from N. Line

990 Ft. from S. Line

330 Ft. from E. Line

_____ Ft. from W. Line

Ottawa County

Location X

Rig up _____

Drilling and Remarks:

RECORD

Cased _____ in., _____ ft.

Sand _____

Gas _____

Oil _____

Total Depth _____

PRODUCTION

1st 24 hrs. Nat. _____

1st 24 hrs. after shot _____

Gas _____ Cu. Ft.

Dry Hole _____

Abandoned _____

Date

III 2 6 1944 19

S. J. LEWIS Scout

Pool Name Wildcat

KANSAS

Map No. 40 Sec. 28 Twp. 9 R. 1W

Well No. 1 Carthier

Phillips Company

Contractor

CORRECTION

NE SE NE

SECTION PLAT

_____ Ft. from N. Line

990 Ft. from S. Line

330 Ft. from E. Line

_____ Ft. from W. Line

			o

Ottawa

Location _____

Rig up _____

Drilling and Remarks:

Reported
NE SE SW

RECORD

Cased _____ in., _____ ft.

Sand _____

Gas _____

Oil _____

Total Depth _____

PRODUCTION

1st 24 hrs. Nat. _____

1st 24 hrs. after shot _____

Gas _____ Cu. Ft.

Dry Hole _____

Abandoned _____

Date

AUG 16 19AA 19

S. J. LEWIS Scout

