

KANSAS

FORM 51 5M 4-41 PETROL

Rooks

Section 28 Township 9 Range 16-W

Well No. 1 Andreson

Company Clay Bros.

NORTH Wildcat

WEST								
	0							
EAST								


SOUTH

Sec. 28 Twp. 9 R. 16-WWell No. #1 Anderson FarmClay Bros. Company

(Wildcat)

 Ft. from N. Line660 Ft. from S. Line Ft. from E. Line330 Ft. from W. Line

Elev. 2072

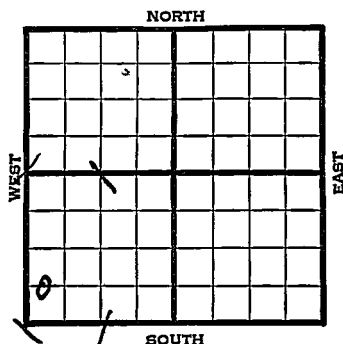

1941

REPORT

5/7

Location

5/15

Rotary.

5/22

10" - 102' Drlg. 1080'

5/28

Anh. 1275' Drlg. 3151'

6/5

Topeka 2940' Lans. 3195'

Cong. 3518' Simp. sand 3563'

Arb. 3569-90' T.D. 5" - 3381'

Plug back.

6/12

T.D. 3590' P.B. to 3330'

6/19

T.D. 3412' 1050 acid.

No shows.

6/26

4000 acid. 1800' water.

Shut down.

7/3

2000 acid. Swab 1 oil & 20 wtr
per hour. Shut down.

OVER

1941

7/9

Arb. 3569'

5" - 3353'

T.D. 3590'

Water.

ABANDONED

Map No. 64 Sec. 28 Twp. 9 R. 16WWell No. 1 AndresonClay Bros.


Company

~~FIRST REPORT~~

Contractor

C W L SW SW

SECTION PLAT

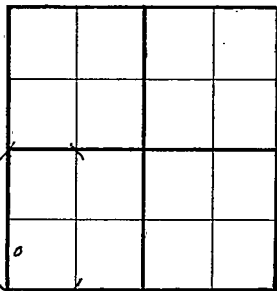 Ft. from N. Line660 Ft. from S. Line Ft. from E. Line330 Ft. from W. Line

WILDCAT

Location XRig up Drilling and Remarks:

RECORD

Cased in., ft.Sand Gas Oil Total Depth

PRODUCTION

1st 24 hrs. Nat. 1st 24 hrs. after shot Gas Cu. Ft.Dry Hole Abandoned

Date

MAY 7 1941 19S. J. LEWIS

Scout

Map No. _____ Sec. 28 Twp. 9 R. 16WWell No. 1 AndresonClay Bros.

Company

ABANDONED

Contractor

C W L SW SW

SECTION PLAT

0			

_____ Ft. from N. Line

660 Ft. from S. Line

_____ Ft. from E. Line

330 Ft. from W. Line

WILDCAT

Location _____

Rig up _____

Drilling and Remarks:

*Ar 8569**5" C 3353**Water.*

RECORD

Cased _____ in., _____ ft.

Sand _____

Gas _____

Oil _____

Total Depth 3590

PRODUCTION

1st 24 hrs. Nat. _____

1st 24 hrs. after shot _____

Gas _____ Cu. Ft.

Dry Hole _____

Abandoned _____

Date

JUL 9 1941 19 S. J. LEWIS Scout