

KANSAS

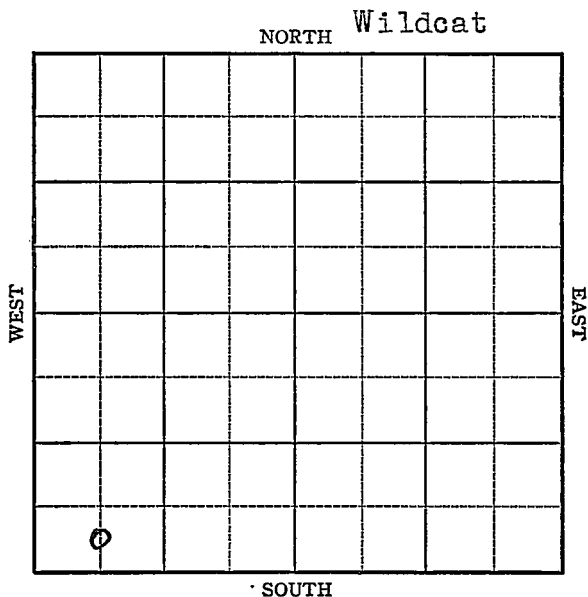
Rooks

FORM 51 5M 10-41 PETROL

Section 28 Township 9 Range 16-W

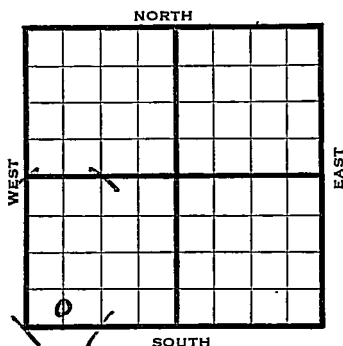
Well No. #1 Anderson

Company W. L. Hartman



Sec. 28 Twp. 9 R. 16-WWell No. #1 Anderson FarmW. L. Hartman Company

(Wildcat)

 Ft. from N. Line330 Ft. from S. Line Ft. from E. Line660 Ft. from W. Line*Elev. 2066*

1942

REPORT

7/1	8" - 120' WOC.
7/8	Shut down.
7/15	" "
7/22	" "
7/29	" "
8/5	" "
8/12	" "
8/19	" "
8/27	" "
9/2	" "
9/9	Drlg 1825
9/16	Drlg 2820
9/23	Lansing 3198-3200 T.D. 7" 3199' RUST
9/30	TD 3286 SSO 3278-85 Treat 1500 gals - C.O.
10/7	5" - 3312 Show water 3320-22 T.D. U.R. 5"
10/14	5" @ 3347 3387 fishing.
10/21	Lans. 3198 5" @ 3347 Water Total depth 3424'

ABANDONED

Rooks

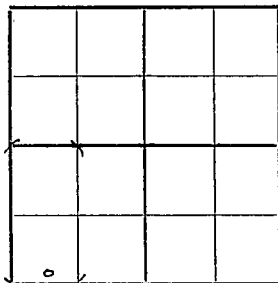
KANSAS

Map No. 64 Sec. 28 Twp. 9 R. 16WWell No. 1 AndresonW. L. Hartman Company**FIRST REPORT**

Contractor

C S $\frac{1}{2}$ SW SW Ft. from N. Line330 Ft. from S. Line Ft. from E. Line660 Ft. from W. Line

Wildcat

SECTION PLATLocation Rig up

Drilling and Remarks:

8" - 120'

Waiting on
cement**RECORD**Cased in., ft.Sand Gas Oil Total Depth **PRODUCTION**1st 24 hrs. Nat. 1st 24 hrs. after shot Gas Cu. Ft.Dry Hole Abandoned

Date

JUL 1 1942 19

S. J. LEWIS

Scout

Rooks

KANSAS

Map No. 604 Sec. 28 Twp. 9 R. 16WWell No. 1 Anderson

W. L. Hartman

Company

ABANDONED

Contractor

C S $\frac{1}{2}$ SW SW

SECTION PLAT

6			

Ft. from N. Line

330 Ft. from S. Line

Ft. from E. Line

660 Ft. from W. Line

WILDCAT

Location

Rig up

Drilling and Remarks:

*Loss 3198**5" @ 3347**Water.*

RECORD

Cased _____ in., _____ ft.

Sand _____

Gas _____

Oil _____

Total Depth 3424

PRODUCTION

1st 24 hrs. Nat. _____

1st 24 hrs. after shot _____

Gas _____ Cu. Ft.

Dry Hole _____

Abandoned _____

Date

OCT 21 1942

19

S. J. LEWIS

Scout