


Section 28 Township 9 Range 16 W

Well No. # 1 Alice Andreseon - SWD

Company TRANSIT DRILG + KRUEGER
~~Skelly Oil~~

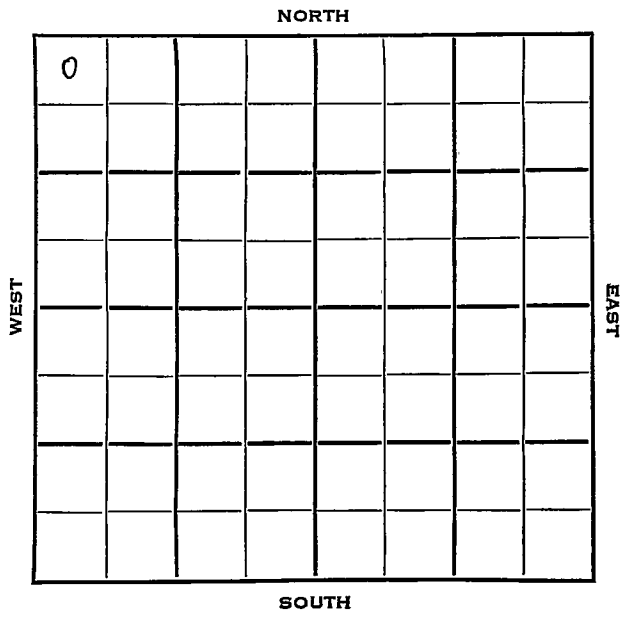

O.W.W.O.

Rooks KANSAS

SEC.	TWP.	R.
28	9	16W ✓

WELL NO.

1 Alice Anderson - SWD

FARM

COMPANY

TRANSIT DELG + KRUEGER
Skelly Oil

CONTRACTOR

Wentworth

S. Dorr Pool

330

Ft. from N. Line


Ft. from S. Line

Ft. from E. Line

330

Ft. from W. Line

NW NW NW

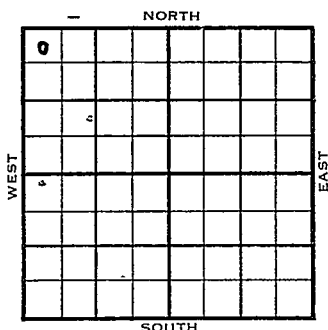

	ELEVATION	REPORT
1954	2064	
5/12	Spud 5-8-54 8" @ 902', WOC	
5/19	Anhy 1291 Top 2949 DST 3134-45, 1 hr, 5' OCM, 30' SW Heeb 3171 Tor 3186 DST 3177-3202, 1 hr, 155' OCM 290# Drilling	
6/30	Spudding 5-8-54 D & A TD 3614 8" @ 1301 Anhy 1291 Top 2949 DST 3134-45 open 1 hr. Rec. 5' ocm 30' sw Heeb 3171 Tor 3186 DST 3177-3202 open 1 hr. Rec. 155' ocm 290# DST 3215-62 open 3/4-hr. Rec. 40' socm 210# DST 3262-90 open 1/2 hr Rec. 10' mud DST 3376-3407 open 1 hr. Rec. 5' oil 10' mud 35# Co Cong 3516 Simp. dol. 3563 Arb 3591 TD 3614 5" @ 3608 CO to 3600 99/3390-3401 500 A PB 3385 54/ 3376-82 500A	

Information brought forward

1954

6/30

S/ 3 bo 5 hr. dec. to 0

PB 3285 54/ 3285 54/ 3258-64 500 A

10 gwph 4 hr.

PB 3255 36/ 3250-54 500 A 18 go

6 gwph 5 hr. 1500 A 58 bfph 5 hr.

50% wtr.

PB 3244

36/ 3237-41 500 A S/ 1 bfph 5 hr. 65%

oil PB 3230 45/ 3215-20 500 A S/ 12

bo 4 bw 10 hr. 1500 A P/ 1 bfph

10% wt.

PB 3210 126/ 3190-3204 500 A S/ 2 bo

1 bw 3 hr. CO to 3206 98/ 3190-3204

500 A 30 83 gw 2 hr. 1500 2 bfph

CO to 3198 49/319-97 500 A S/ 44mgwph

8 hr. CO to 3597 126/ 3509-23 sd-frac

S/12 gwph 8 hr.

D&A

ABANDONED

1957

1/9

OTD 3614 **O.W.W.O.**

8" @ 130/400

CO to make SWD

KansasCounty Rooks StateSec. 28 (Blk. Twp.) 9 (Sur. Rge.) 16W Map No.Operator Skelly OilWell No. 1 Farm Alice AndresonElev. Location NW NW NW0 330 Ft. From N Line NW330 Ft. From W Line Quarter1st. Report MAY 12 1954


Completion

Remarks

Wentworth - Contr.Spudding Date 5-8-54Drlg. Data S. Dorr Pool8" @ 902 WOC

J. G. McGEHEE

County _____ Rocks _____ State **Kansas**
 Sec. 28 (Blk. Twp.) 9 (Sur. Rge.) 16W Map No. _____
 Operator Skelly Oil
 Well No. 1 Farm Alice Andreson
 Elev. 2064 Location NW NW NW

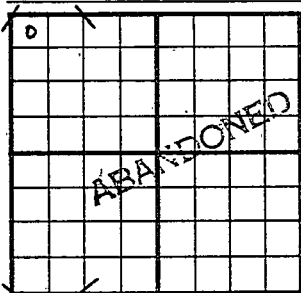

330 Ft. From N Line NW
 330 Ft. From W Line Quarter

1st. Report

JUN 30 1954

Completion

Remarks S. Dorr Pool

Wentworth - Contr.

Spudding Date 5-8-54

Drilg. Data D & A TD 3614

8" @ 1301 Anhy 1291 Top. 2949

DST 3134-45 open 1 hr. Rec. 5' ocm

30' sw Heeb. 3171 Tor. 3186

DST 3177-3202 open 1 hr. Rec. 155' ocm

290# DST 3215-62 open 3/4 hr. Rec.

40' socm 210# DST 3262-90 open 1/2 hr.

Rec. 10" mud DST 3376-3407 open 1 hr.

Rec. 5' oil 10' mud 35# Cong. 3516

Simp. dol. 3563 Arb. 3591 TD 3614

5" @ 3608 00 to 3600 99/ 3390-3401

500 A PB 3385 54/ 3376-82 500 A

S/ 3 bo 5 hr. dec. to 0' PB 3285

54/ 3258-64 500 A 10 gwph 4 hr.

PB 3255 36/ 3250-54 500 A 18 go

Drlg. Data

6 gwph 5 hr. 1500 A 58 bfph 5 hr.

50% wtr. PB 3244 36/ 3237-41

500 A S/ 1 bfph 5 hr. 65% oil

PR 3230 45/ 3215-20 500 A S/ 12 bo

4 bw 10 hr. 1500 A P/ 1 bfph 10% wt.

PB 3210 126/ 3190-3204 500 A

S/ 2 bo 1 bw 3 hr. CO to 3206


98/ 3190-3204 500 A 30-go 83 gw 2 hr.

1500 A 2 bfph CO to 3198 49/ 3190-97

500 A S/ 44 gwph 8 hr. CO to 3597

126/ 3509-23 sd-frac S/ 12 gwph 8 hr.

D & A

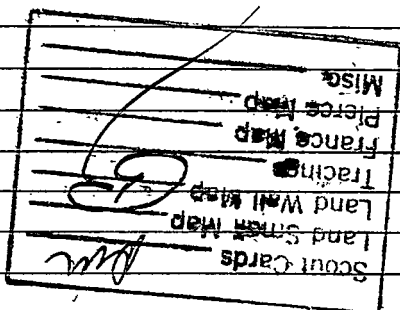

8 1954

O.W.W.O.

FORM 513 SUNRAY

County Booke Elev. 2064
 Sec. 28 Twp. 9 Rge. 16W
 Company Transit Drig. & Krueger
 FarmName Anderson SWD No. 1

TOPS	DEPTH	LOG	DATUM
Anh.			
Tr.			
H.			
Tr.			
Dg.			
Bl.			
L.			
K.C.			
B.K.C.			
Ce.			
C.			
M.			
M.			
K.			
Mz.			
Ma.			
V.			
S.			
S.			
A.			
R.			
Pe.			
G.			
T.D.			

Loc. in Sec.

NW NW NW

O.W.W.O.

Geol. O.W.W.O.

Contr.

Pool

S. Torr

FIRST REPORT
 JAN 9 '37


Date Comm.

8" @ 130/1:00 OTD 3614 GO to make

SWD

County Rooks Elev. 2064
 Sec. 28 Twp. 9 Rge. 16W
 Company Transit Drilling & Krueger
 Farm Name Andreson SWD No. 1

TOPS	DEPTH	LOG	DATUM	Loc. in Sec.
Anb.				NW NW NW
Tr.				
H.				OWWO
Tr.				
Dg.				
Bl.				
L.				Geol.
K.C.				Contr.
B.K.C.				
Ce.				
C.				
M.				Pool
M.				S. Corr
K.				
Mz.				
Mo.				
V.				
S.				
A.	3591			
R.				
Pe.				
G.				
TD.				

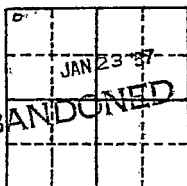

Date Comm. 8/8 1301/400
 8" @ 150/400 OTD 3614 CC to make

SWD 1200 prep to PF.

80/910-1010 input

25 Boph complete for
 SWD well.