


Section 28 Township 9 Range 17 W

Well No. # 1 Benedict

Company Barnett Drlg.

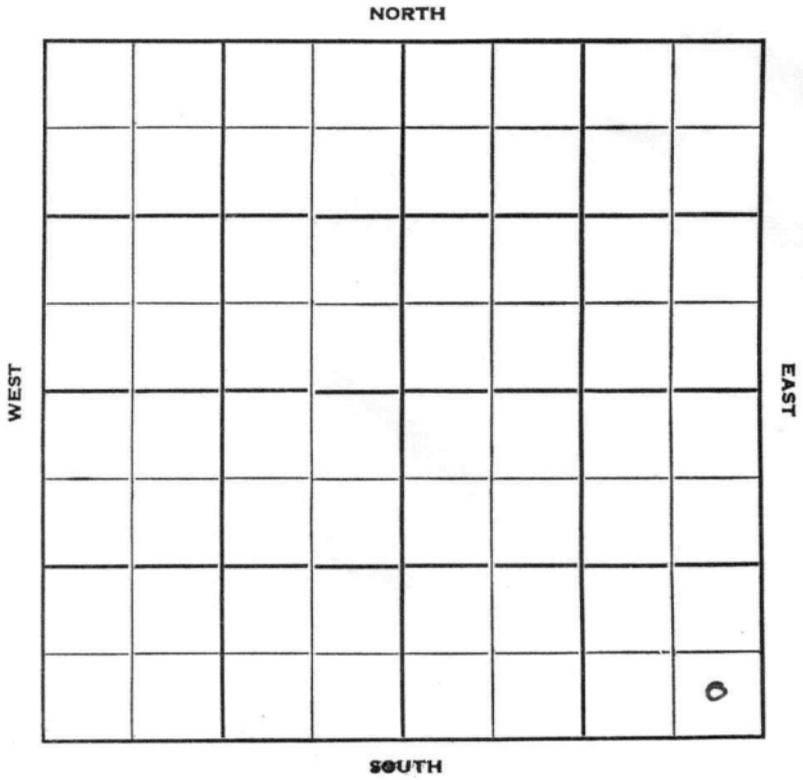

Rooks

KANSAS
17W

Sec. 28 Twp. 9 R. 17W

Well No. #1 Benedict Farm

Barnett Drlg. Company


Semi-Wildcat Contractor

_____ Ft. from N. Line

330' Ft. from S. Line

330' Ft. from E. Line

_____ Ft. from W. Line

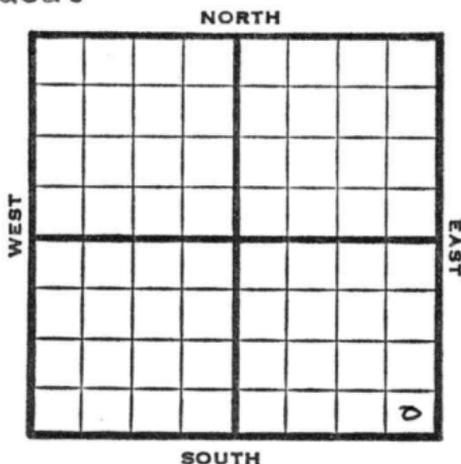

SE SE SE

1951 Elev. 2090' REPORT

2/21 Location

3/14 Spud 2-21-51
 D&A TD 3659
 8" @ 164'
 Anhy 1400' Top. 3008'
 DST 3165-81 opn 1/2 hr Rec. 30' mud
 Heeb. 3223' Toronto 3241
 Lans. 3243
 DST 3288-3310 opn 45 min Rec. 45' mud
 DST 3357-67 opn 1 hr Rec. 75' sw
 Cong. 3545 BKC 3497
 Rework Simp. 3592 Simp. 3616
 Arb. 3631 TD 3659
 D&A **ABANDONED**

