

Rooks

KANSASSection 28 Township 9 Range 18WWell No. 1 E. RempeCompany Skelly

Paradise Pool

NORTH

				0			

WEST

EAST

SOUTH

KANSAS

Rooks

Sec. 28 Twp. 9 R. 18-W

Well No. #1 E. Rempe Farm


Skelly Company
Paradise Pool

330 Ft. from N. Line

 Ft. from S. Line

 Ft. from E. Line

330 Ft. from W. Line

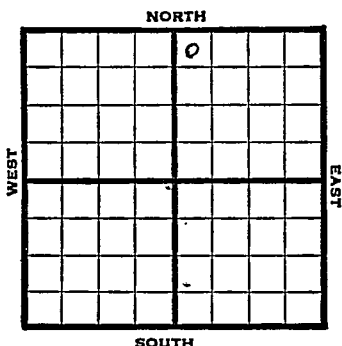

NW NE Elev. 2165'

REPORT

1947

3/19 Location

3/18 13" @ 175'
WOC

4/2 Anhy 1488'
8" @ 1496
Drlg 1605'

4/9 Lans 3341'
Drlg 3445'

4/15 Arbuckle 3495'-97' TD
5" @ 3595'
RUST

4/23 " " " "
4/29 Pump 63 bbls. oil in 7 hrs.

5/7 " "

5/13 " "

5/20 " "

5/27 " "

6/3 " "

6/19 " "
6/21 " "

1947

6/24 Pump 65 bbls oil in 7 hrs.

7/1 " " " "

7/8 " " " "

7-16 " " " "

7/22 " " " "

7/30 Arb. 3594'
5" @ 3595'
Pump 259 Pot.
Gr. 27.3
TD 3597'

COMPLETED


KANSAS
Kansas

Paradise Pool

Map No. 64 Sec. 28 Twp. 9 R. 18WWell No. 1 E. RempeSkelly Company**FIRST REPORT** Contractor

NW NE

SECTION PLAT

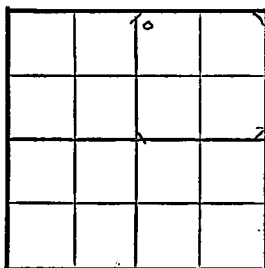330 Ft. from N. Line Ft. from S. Line Ft. from E. Line330 Ft. from W. Line

Rooks County

Location XRig up

Drilling and Remarks:

RECORD

Cased in., ft.Sand Gas Oil Total Depth

PRODUCTION

1st 24 hrs. Nat. 1st 24 hrs. after shot Gas Cu. Ft.Dry Hole Abandoned

Date

MAR 19 1947 19 S. J. LEWIS Scout

Map No. 64 ^{Kansas} Sec. 28 Twp. 9 R. 18W

Well No. 1 E. Rempe

Skelly

Company

COMPLETE

Contractor

NW NE


E 1/2 165
SECTION PLAT

330 Ft. from N. Line

_____ Ft. from S. Line

_____ Ft. from E. Line

330 Ft. from W. Line

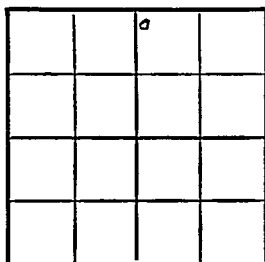

Rooks County

RECORD

Location _____

Cased _____ in., _____ ft.

Rig up _____

Sand _____

Drilling and Remarks:

Gas _____

Oil _____

Total Depth 2092

PRODUCTION

1st 24 hrs. Nat. _____

1st 24 hrs. after shot _____

Gas _____ Cu. Ft.

Dry Hole _____

Abandoned _____

Date

JUL 30 1947 19

S. J. LEWIS

Scout