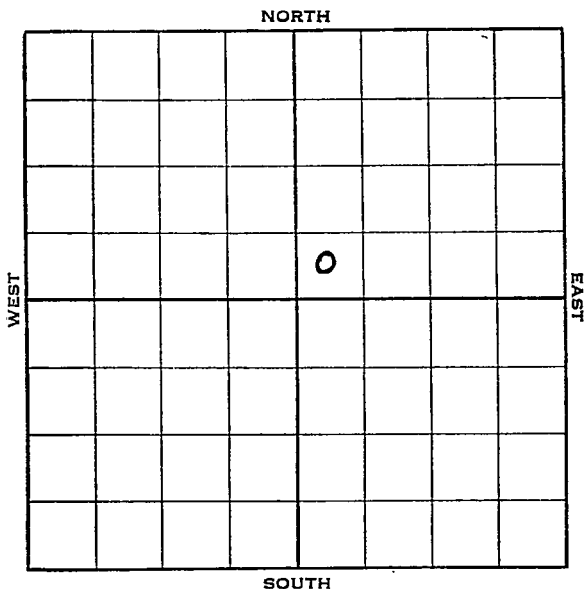



Section 28 Township 9 Range 19-WWell No. 1 SutorCompany Duwe & Farris

KANSAS

Rooks

Sec. 28 Twp. 9 R. 19-WWell No. #1 Sutor Farm
Duwe & Farris Company Ft. from N. Line330 Ft. from S. Line Ft. from E. Line330 Ft. from W. Line

Elev. 2201

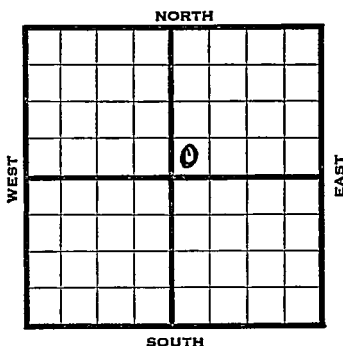

1938	REPORT
4/27	B.R.R.
5/6	"
5/12	10" @ 117'.
	WOC.
5/20	" "
5/27	Drlg. 940'.
6/3	Anhy 1578'. - Ft. Riley 2295'.
	Florence Flint 2395'.
	Wreford 2455'. Drlg. 3095'.
6/8	Topeka 3148'.
	Dodge 3375'.
	Good sat. & Porosity 3375-90'.
	Lans. 3413'.
	Cong. 3650'.
	Arb. 3723-35'. No shows.
	T. D. 3735'.
	ABANDONED

Rooks KANSAS

Map No. 65 Sec. 28 Twp. 9 R. 19WWell No. 1 SutorDuwe & Farris

Company

Contractor

FIRST REPORT

SW NE

Ft. from N. Line

330 Ft. from S. Line

Ft. from E. Line

330 Ft. from W. Line

SECTION PLAT

		0	

Location _____

Rig up _____

Drilling and Remarks:

BRR

RECORD

Cased _____ in., _____ ft.

Sand _____

Gas _____

Oil _____

Total Depth _____

PRODUCTION

1st 24 hrs. Nat. _____

1st 24 hrs. after shot _____

Gas _____ Cu. Ft.

Dry Hole _____

Abandoned _____

Date

APR 27 1938 19

H. D. Hatfield

Scout

Rooks KANSAS

Map No. 65 Sec. 28 Twp. 9 R. 19WWell No. 1 SutorDuwe & Farris

Company

Contractor

ABANDONED
SW NE

SECTION PLAT

		0	

 Ft. from N. Line330 Ft. from S. Line Ft. from E. Line330 Ft. from W. LineLocation Rig up

Drilling and Remarks:

Topeka 3148
Dodge 3375
good sat & Porosity
3375-90
LENS 3413
CONG 3650
ARB 3723-3570
No Shows DYA

RECORD

Cased in., ft.Sand Gas Oil Total Depth 3735

PRODUCTION

1st 24 hrs. Nat. 1st 24 hrs. after shot Gas Cu. Ft.Dry Hole Abandoned

Date

JUN 8 - 1938

19

H. D. Hatfield

Scout