


Section 28 Township 9 Range 20 WWell No. # 4 KernCompany Nadel & Gussman

NORTH

WEST

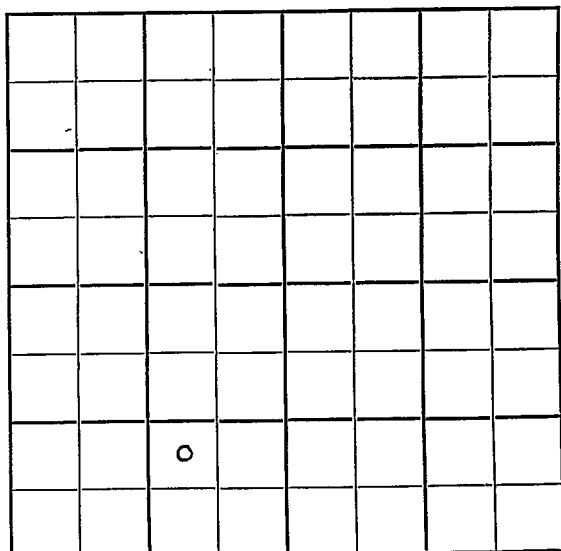

EAST

SOUTH

Sec. 28 Twp. 9 R. 20W

Well No. #4 Kern Farm

Nadel & Gussman Company

Nadel & Gussman - Contr. Contractor

Kern Pool


 Ft. from N. Line

990' Ft. from S. Line

990' Ft. from E. Line

 Ft. from W. Line

NW SE SW

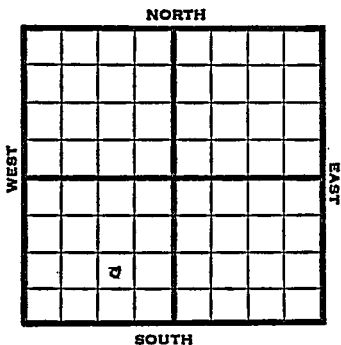

1951

Elev. 2290'

REPORT

3/28

RUR

5/9

Spud 3-27-51

Oil well TD 3864'

8" @ 159' Anhy 1779', Heeb 3527',

Lans. 3566', Tor. 3548', Cong 3839',

Simp. dol. 3848', Simp. sh. 3850',

Arb. 3861',

5" @ 3862' TD 3864', FU 2600' oil

S/5 BOPH 500 A S/ 90 BOPH

Comp. Echo pot. 3000 BOPD

COMPLETED

J. E. TYRA

County Rooks State Kansas

Sec. 28 (Blk. Twp.) 9 (Sur. Rge.) 20W Map No.

Operator Nadel & Gussman

Well No. 4 Farm Kern

Elev.	2290	Location	NW	SE	SW
-------	------	----------	----	----	----

[illegible][illegible][illegible]

Completion MAY 9 1951

[illegible][illegible][illegible]

047 11

ED 5064

Eng. Data	Oil Well	ID 0001







LE TYRA

J. E. TYRA