


Section 28 Township 9 Range 20W

Well No. #2 Kern

Company Nadel & Gussman

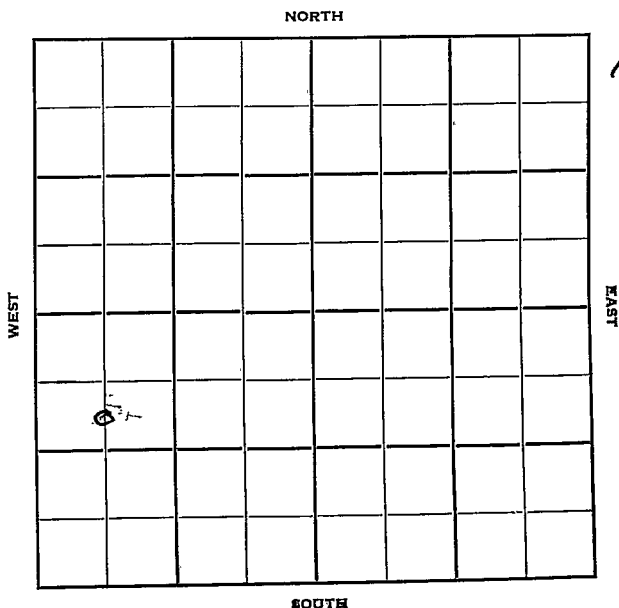

12

Rooks

KANSAS

Sec. 28 Twp. 9 R. 20W

Well No. #2 Kern Farm

Nadel & Gussman Company

Reserve Drlg. Contr. Contractor


990' Ft. from N. Line

Ft. from S. Line

Ft. from E. Line

660' Ft. from W. Line

C S L NW SW

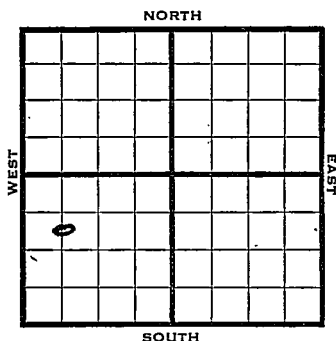

1950 Elev. 2289' REPORT

8/23 Spud 8-18-50  
8" @ 138'  
Anhy 1780'

10/11 Drlg. 2430'  
Spud 8-18-50  
Oil Well TD 3884'  
8" @ 318' Anhy 1780'  
Heeb 3534' Simp 3871'  
Arb. 3881'  
TD 3883' 5" @ 3881'  
DD 3884' FU 200' oil 12 hr.  
500A S/5 BOPH Comp. 112 BOPD

COMPLETED


J. É. TYRA

County \_\_\_\_\_ Rooks \_\_\_\_\_ State Kansas  
 Sec. 28 (Blk.) 9 (Sur.) 20W Map No. \_\_\_\_\_  
 (Twp.) (Rge.)

Operator Nadel & Gussman

Well No. 2 Farm Kern

Elev. 2289 Location C S L NW SW

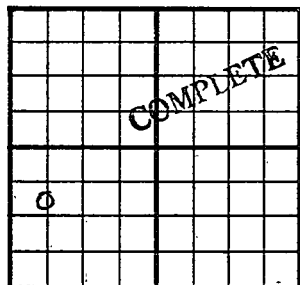

990 Ft. From N Line SW

660 Ft. From W Line Quarter

Ist. Report

Completion OCT 11 1950

Remarks Kern Pool

Reserve Drlg. - Contr.

Spudding Date 8-18-50

Drlg. Data Oil well TD 3884

8" @ 318 Anhy 1780 Heeb. 3534

Simp. 3871 Arb. 3881 TD 3883 5" @ 3881

DD 3884 FU 200' oil 12 hr. 500 A

S/ 5 boph Comp. 112 bopd

J. E. TYRA