


Section 28 Township 9 Range 20 W

Well No. #3 Kern

Company Nadel & Gussman

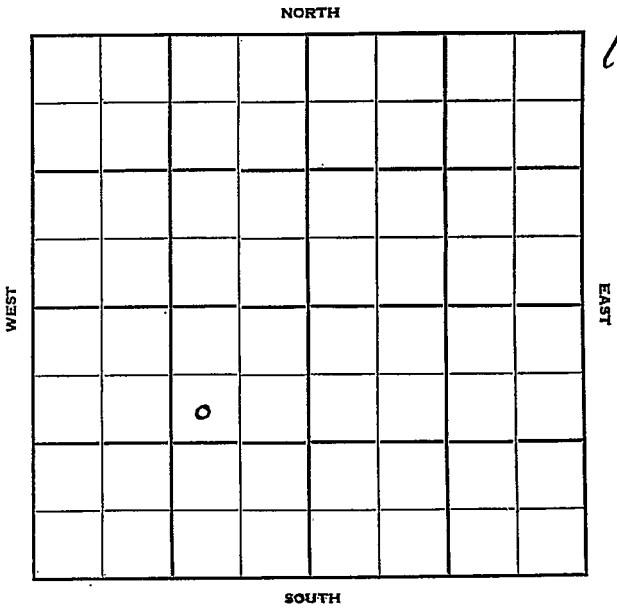

Sec. 28 Twp. 9 R. 20W ✓

Well No. #3 Kern Farm

Nadel & Gussman Company


Kern Pool Contractor

990' Ft. from N. Line

\_\_\_\_\_ Ft. from S. Line

990' Ft. from E. Line

\_\_\_\_\_ Ft. from W. Line

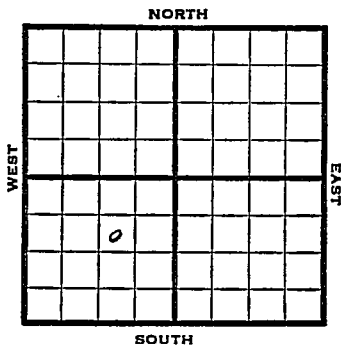

SW NE SW

1951

Elev. 2290' REPORT

1/17

Location

2/21

Spud 1-19-51

Oil well TD 3865

8" @125

Anhy 1783 Heeb 3527 Toronto 3548

Lans. 3565 Cong. 3825 Simp. 3847

Arb. 3862-65 TD

5" @3865 S/ 45 boph 500 A

S/ 71 boph

Comp. draw down pot. 20140 bopd

**COMPLETED**



