

Graham

KANSAS

SECTION 28 TOWNSHIP 9 RANGE 21 W

WELL NO. #2 Dodson

COMPANY Elreco

NORTH

0							

13

WEST

EAST

SOUTH

Graham

KANSAS

SEC.	TWP.	R.
28	9	21W

WELL NO.

#2 Dodson

FARM

COMPANY

Elreco

CONTRACTOR

K & E Drlg.

Morel


Ft. from N. Line

Ft. from S. Line

Ft. from E. Line

Ft. from W. Line

SW SW SW

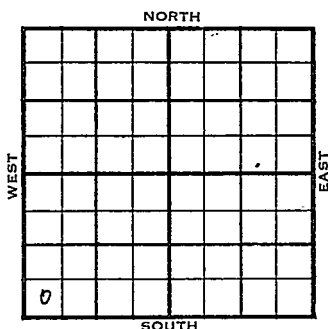

1956

ELEVATION

2330 DF

REPORT

1-5-

Comm. 12-29-55

8" @ 222

Drlg. 3100

2-8

DST 3891-96 op 1 hr. rec. 90' Mdy oil

BHP 930/15

DST 3898-3904 30" rec ~~####~~ 1020' oil

plus 120' OCM, FP 70-440, BHP 1135/

5 1/2" @ 3898/75

MICT

CO 3904

FU 800' oil no/wtr, 30"

FU 2700' oil, 4 1/2 hr.

S/ 76 BO no/wtr. 2 hrs., 800' O.B.

FU 3000' oil, 15 1/2 hrs.

POP

Waiting on potential

2948 BOPD no/wtr

H. 3511

Te. 3535

L. 3550

KC 3553

C. 3844

A. 3891

TD 3904

COMPLETED

County Graham Elev. 21W
 Sec. 28 Twp. 21N Rge. 21W
 Company Elreco
 Farm Name Dodson No. 2

TOPS	DEPTH	LOG	DATUM	Loc. in Sec.
Anh.				SW SW SW
Top				
H.				
Tr.				
Dg.				
BL.				
L.				
K.C.				Geol.
B.K.C.				Contr. <u>A & E Drlg.</u>
Ce.				
C.				
M.				Pool
M.				Morel
K.				
Mz.				
Mq.				
V.				
S.				
S.				
A.				
R.				
Pe.				
G.				
T.D.				

Date Comm. 12-29-55
8" @ 222 drlg. 3100

FIRST REPORT
 JAN 5 56

County Graham Elev. 2330 DF
 Sec. 28 Twp. 9N Rge. 21W
 Company Elreco
 Farm Name Dodson No. 2

TOPS	DEPTH	LOG	DATUM	Loc. in Sec.
Asb				SW SW SW
TP				
H	3511			
Tr	3535			
Dr				
RL				
L	3550		1220	Geol.
RC	3553		1223	
RKC				Conts
Co.				K & E Drilg.
C	3844		1514	
M				Pool
N				Morel
K				
Dr				
Mo				
V				
S				
S				
A	3891		1561	COMPLETE
R				
FE				
S				
Dr	3904			

Date Comm. 12-29-55 FEB 8 1956

0222 drilg. 3100 JAN 11 56

VST 3891-96 1hr rec 90' Mdy 0
 BHP 930/15 VST 3898-3904
 30" rec 1020' oil + 120' OCM
 FP 70-440 BHP 1135/ 5 1/2
 3898/75 MILET JAN 18 56 CO 3904
 FU 800' oil no/w 30". FU 2700' oil
 4 1/2 hr. 76 BO no/w 2 hrs.
 800' O.B. T&R FU 3000' oil 15 1/2

Mr. Pop JAN 25 76 Ws POT FEB 1 76
FEB 8 76 Echo 2948 Bopd Hs/wh

FEB 22 1956

R. G.