


Section 28 Township 9 Range 22 WWell No. # 1 MooreCompany Transit Drlg. & Davis Bros.

NORTH

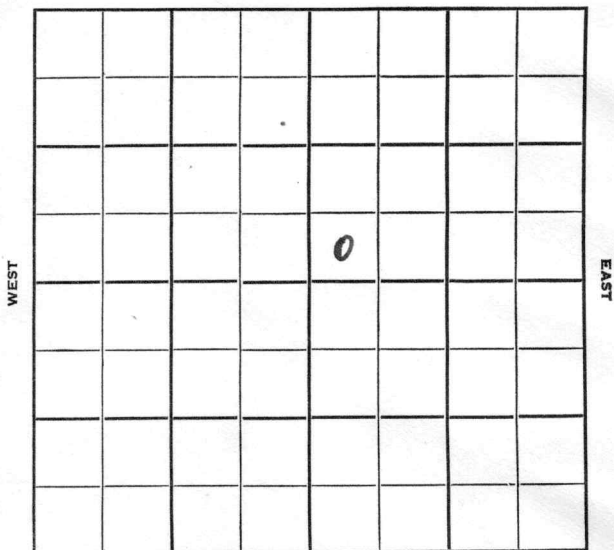

SOUTH

Graham

KANSAS ✓

Sec. 28 Twp. 9 R. 22WWell No. #1 Moore FarmTransit Drlg. & Davis Bros. CompanyTransit Drlg. ContractorWildcat.

Ft. from N. Line

330

Ft. from S. Line

Ft. from E. Line


330

Ft. from W. Line

SW SW NE

Magnolia F/O

Derby & Skelly - DHM

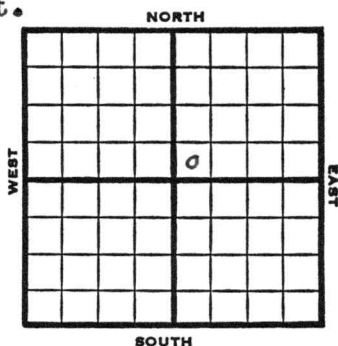

1953

Elev. 2381' REPORT

6/24

Loc.

7/1

8" @ 194

Anhy 1800', Lans 3652

Drlg. 3700'

7/8

D & A

7/22

Spud 6-24-53 D & A TD 4070

8" @ 194 Anhy 1800 Lans 3652

Marm. 3863 Cong. 3995 Simp 4011

Ero-Arb. 4019' Arb. 4024

DST 4021-33 open 1 hr rec 30' OCM

800# TD 4070'

D & A

ABANDONED

4024

2381

643

3652
2381
12713995
2381
16142381
1800
5812381
1800
581


County Graham State KansasSec. 28 (Blk.) 9 (Sur.) 22W Map No.Operator Transit Drlg. & Davis Bros.Well No. 1 Farm MooreElev. Location SW SW NE330 Ft. From S Line NE330 Ft. From W Line Quarter1st. Report JUN 24 1953

Completion

Remarks Magnolia farmout
Derby & Skelly - DUMTransit Drlg. - Contr.

Spudding Date

Drlg. Data Wildcat

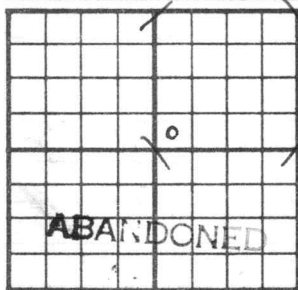County Graham State KansasSec. 28 (Blk. 9) (Sur. 22W) Map No. 22WOperator Transit Drlg. & Davis Bros.Well No. 1 Farm MooreElev. 2381 Location SW SWNE330 Ft. From S Line NE330 Ft. From W Line Quarter1st. Report JUL 22 1953Completion JUL 22 1953Remarks WildcatTransit Drlg. - Contr.Spudding Date 6-24-53Drlg. Data D & A TD 40708" @ 194 Anhy 1800 Lans. 3652Marm. 3863 Cong. 3995 Simp. 4011EroArb. 4019 Arb. 4024 DST 4021-33open 1 hr. Rec. 30' ocm 800#TD 4070D & A