

1-9-28W

STATE CORPORATION COMMISSION OF KANSAS
OIL & GAS CONSERVATION DIVISION
WELL COMPLETION OR RECOMPLETION FORM
ACO-1 WELL HISTORY
DESCRIPTION OF WELL AND LEASE

Operator: License # 5533
Name Arrowhead Petroleum, Inc.
Address P.O. Box 8287 - Munger Station
City/State/Zip Wichita, Kansas, 67208

Purchaser

Operator Contact Person Wm. Todd Seymour
Phone (316) 681-3921

Contractor: License # 5381
Name Big Springs Drilling, Inc.

Wellsite Geologist Wm. Todd Seymour
Phone (316) 681-3921

Designate Type of Completion

New Well Re-Entry Workover
 Oil SWD Temp Abd
 Gas Inj Delayed Comp.
 Dry Other (Core, Water Supply etc.)

If OMWO: old well info as follows:

Operator
Well Name
Comp. Date Old Total Depth

WELL HISTORY

Drilling Method:

Mud Rotary Air Rotary Cable

1-13-86 1-15-86 1-15-86
Spud Date Date Reached TD Completion Date

2460'
Total Depth PBTD

Amount of Surface Pipe Set and Cemented at 285' feet

Multiple Stage Cementing Collar Used? Yes No
If yes, show depth set feet

If alternate 2 completion, cement circulated from 0 feet depth to 285 w/ 160 SX cmt

Cement Company Name Halliburton
Invoice # 401082

API NO. 15-179 - 20,857
County Sheridan
NE NE NE 1 9S 28W East
Sec Twp Rge West

4950'
330'
Ft North from Southeast Corner of Section
Ft West from Southeast Corner of Section
(Note: Locate well in section plat below)


Lease Name Herl Well # 1

Field Name

Producing Formation

Elevation: Ground 2654' KB 2659'

Section Plat

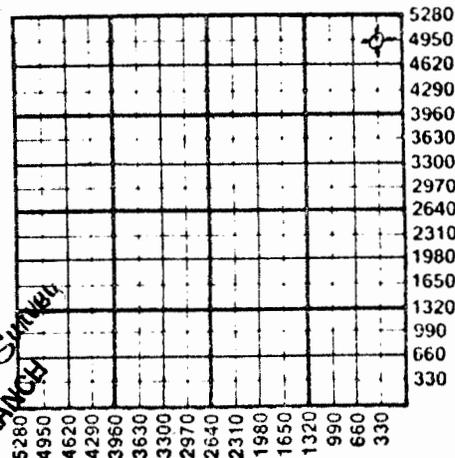

FEB 03 1986
State Geological Survey
WICHITA BRANCH

WATER SUPPLY INFORMATION

Disposition of Produced Water: Disposal
Bucket # Repressuring

Questions on this portion of the ACO-1 call:

Water Resources Board (913) 296-3717

Source of Water: Water Well T 86 - 35
Division of Water Resources Permit #

Groundwater 4950 Ft North from Southeast Corner
(Well) 330 Ft West from Southeast Corner of
Sec 1 Twp 9 Rge 28W East West

Surface Water Ft North from Southeast Corner
(Stream, pond etc) Ft West from Southeast Corner
Sec Twp Rge East West

Other (explain)
(purchased from city, R.W.D. #)

INSTRUCTIONS: This form shall be completed in duplicate and filed with the Kansas Corporation Commission, 200 Colorado Derby Building, Wichita, Kansas 67202, within 90 days after completion or recompletion of any well. Rule 82-3-130 and 82-3-107 apply.

Information on side two of this form will be held confidential for a period of 12 months if requested in writing and submitted with the form. See rule 82-3-107 for confidentiality in excess of 12 months. One copy of all wireline logs and drillers time log shall be attached with this form. Submit CP-4 form with all plugged wells. Submit CP-111 form with all temporarily abandoned wells.

69158

SIDE TWO

Operator Name Arrowhead Petroleum, Inc. Lease Name..... Herl Well #..... 1

Sec..... 1 Twp..... 9S Rge..... 28W East West County..... Sheridan

WELL LOG

INSTRUCTIONS: Show important tops and base of formations penetrated. Detail all cores. Report all drill stem tests giving interval tested, time tool open and closed, flowing and shut-in pressures, whether shut-in pressure reached static level, hydrostatic pressures, bottom hole temperature, fluid recovery, and flow rates if gas to surface during test. Attach extra sheet if more space is needed. Attach copy of log.

Drill Stem Tests Taken Yes No
 Samples Sent to Geological Survey Yes No
 Cores Taken Yes No

Formation Description
 Log Sample

Name Top Bottom

Log run to check top & base of Anhydrite Section.

Top 2289'
 Base 2323'

CASING RECORD <input checked="" type="checkbox"/> New <input type="checkbox"/> Used							
Report all strings set-conductor, surface, intermediate, production, etc.							
Purpose of String	Size Hole Drilled	Size Casing Set (in O.D.)	Weight Lbs/Ft.	Setting Depth	Type of Cement	#Sacks Used	Type and Percent Additives
Surface	12 1/4"	8 5/8"	20#	285'	60-40 POZ	160SX	2% gel 3%cc1
PERFORATION RECORD				Acid, Fracture, Shot, Cement Squeeze Record			
Shots Per Foot	Specify Footage of Each Interval Perforated			(Amount and Kind of Material Used)		Depth	
.....	
.....	
.....	
.....	
TUBING RECORD				Liner Run <input type="checkbox"/> Yes <input type="checkbox"/> No			
Date of First Production		Producing Method					