FORM 51 25M 3-49 PETROL

KANSAS

Ottawa


Section 29 Township 9 Range 1W

Well No. 1 Foote E1

Company Westgate-Greenland

Wildcat

2

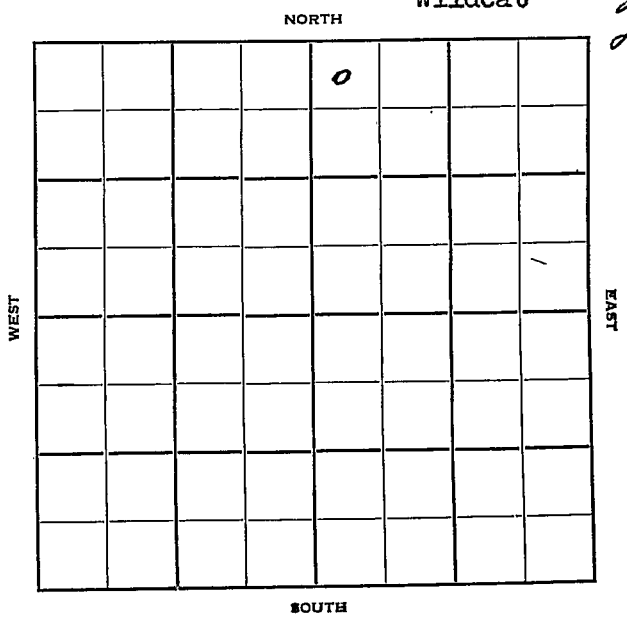

FORM 252-A
5M 10-48 PETROL

KANSAS Ottawa

Sec. 29 Twp. 9 R. 1W

Well No. #1 Foote Farm

Westgate-Greenland Company

Wildcat


330' Ft. from N. Line

Ft. from S. Line

Ft. from E. Line

330' Ft. from W. Line

NW NE

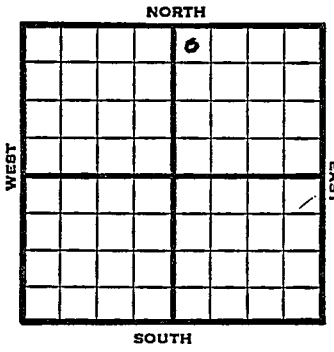

1949	Elev 1367' REPORT
4/13	RUR
4/20	8"@ 158'
	Drlg 2375'
4/20	TD 3613'
	Miss 2662'
	Hunton 2982'
	Viola 3332'
	Simp Sd 3502'
	Arb. 3570'
	Aband.
	ABANDONED

Form 26 200 Bks. 9-48 Petrol

Kansas

Wildcat

Map No. _____ Sec. 29 Twp. 9 R. 1W

Well No. 1 Foote

Westgate-Greenland Company

FIRST REPORT Contractor

NW NE

330 Ft. from N. Line


_____ Ft. from S. Line

_____ Ft. from E. Line

330 Ft. from W. Line

Ottawa County

SECTION PLAT

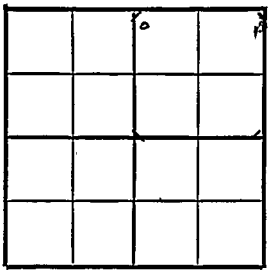

Location _____

Rig up _____

Drilling and Remarks:

R U R

RECORD

Cased _____ in., _____ ft.

Sand _____

Gas _____

Oil _____

Total Depth _____

PRODUCTION

1st 24 hrs. Nat. _____

1st 24 hrs. after shot _____

Gas _____ Cu. Ft.

Dry Hole _____

Abandoned _____

Date

APR 13 1949 19

S. I. LEWIS Scout

Form 26 200 Bks. 9-48 Petrol

Wildcat

Kansas

Map No. K60 Sec. 29 Twp. 9 R. 1W

Well No. 1 Foote


Westgate-Greenland Company

ABANDONED Contractor

NW NE

E 1/1367

SECTION PLAT

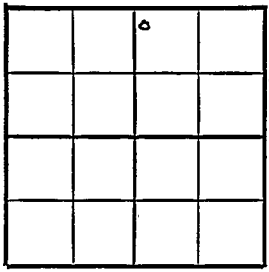

330 Ft. from N. Line

Ft. from S. Line

Ft. from E. Line

330 Ft. from W. Line

Ottawa County

Location

Rig up

Drilling and Remarks:

Miss 2662

Hunton 2982

Viola 3332.

Simp Sd 3502

TD 3590

RECORD

Cased in., ft.

Sand

Gas

Oil

Total Depth 3613

PRODUCTION

1st 24 hrs. Nat.

1st 24 hrs. after shot

Gas Cu. Ft.

Dry Hole

Abandoned

Date

APR 20 1949 19

S. J. LEWIS Scout