


Rooks

KANSAS

SECTION 29 TOWNSHIP 9 RANGE 17W

WELL NO. #1 Rampe

COMPANY K & E Drlg. & Oil Trading

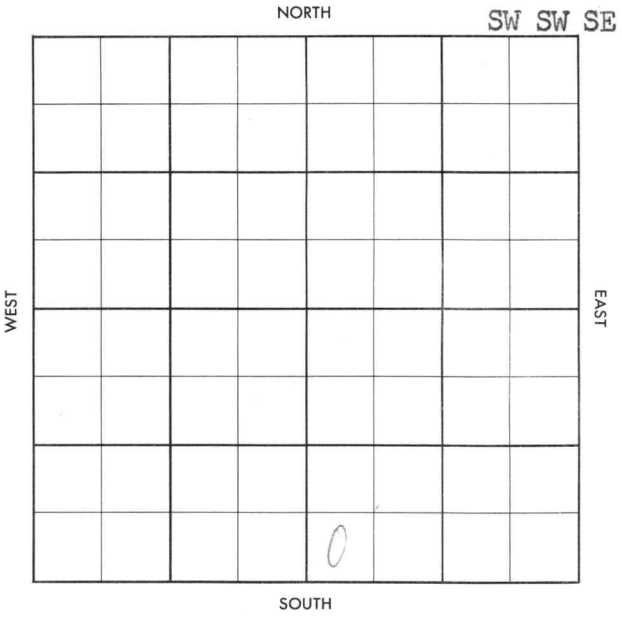

WILDCAT

FORM 513 SUNRAY

County Rooks Elev. _____
 Sec. 29 Twp. 9 Rge. 17W
 Company K & E Drlg. & Oil Trading
 Farm Name Rampe No. 1

TOPS	DEPTH	LOG	DATUM	Loc. in Sec.
Anh.				SW SW SE
TP.				
H.				
Tr.				
Dg.				
Bl.				
L.				Geol. _____
K.C.				Contr. _____
B.K.C.				K & E Drlg.
Ce.				
C.				Pool _____
M.				Wildcat
K.				
Mz.				
Me.				
V.				
S.				
S.				
A.				
R.				
PE.				
G.				
T.D.				

AUG 14 1957			
FIRST REPORT			
0			

Date Comm. MIRT

Co. Use. No. Sec. T. R.

