


Section 29 Township 9 Range 18 W

Well No. # 3 Baumgartner

Company Heathman & Co.

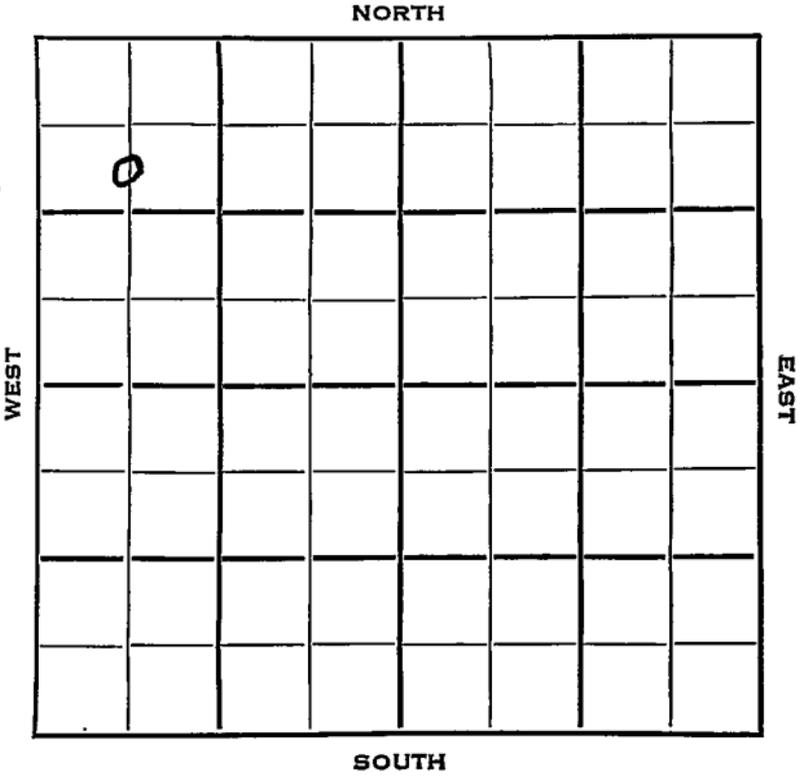

Rooks

KANSAS

Sec. 29 Twp. 9 R. 10W

Well No. #3 Baumgartner Farm

Heathman & Co. Company

Strain Drlg. Contractor


990 Ft. from N. Line

_____ Ft. from S. Line

_____ Ft. from E. Line

660 Ft. from W. Line

C S L NW NW

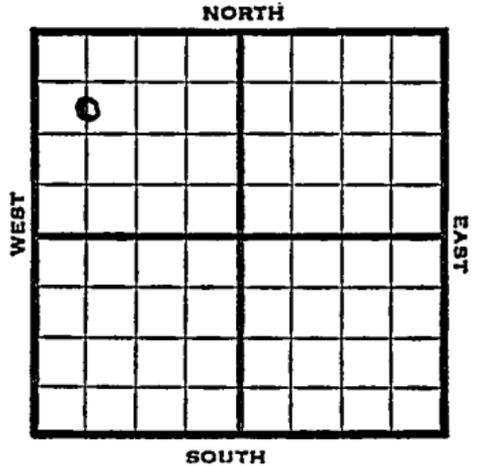

1953

Elev. 2185'

REPORT

6/10

Spud 6-4-53
8" @ 155'
Anhy 1567'
Drlg 2860'

6/24


No report

7/8

Spud 6-4-53
Oil Well
TD 3655'
8" @ 155'
Anhy 1567', Heeb 3317', Tor 3337',
Lans 3358',
DST 3447-60, opn 1 hr, rec 20' ocm,
42' wcm 890#
DST 3519-37 opn 1/2 hr, rec 72' mud, &
SSO 920# Arb 3599,
DST 3600-11 opn 1/2 hr, rec 15' ocm,
660#
DST 3611-32 opn 1 hr, rec 315' vhocm
980#
DST 3632-55 opn 1/2 hr, rec 2100' sw,
5" @ 3654'
CO to 3652'
24/ 3642-50 rec 2000' wtr, CO to 3654,
24/ 3630-35, B/ 5 go 15 gw SP 3625
23/ 3620-24 B/ 11 goph 500 A S/ 15
boph 13 bw SP 3615 23/ 3600-09 S/
13 boph CO to 3622 S/ 17 boph
2000 A Comp. 1018 bopd.

COMPLETED

County _____ Rooks _____ State Kansas
 Sec. 29 (Blk. 9 (Sur. 18W Map No. _____
 (Twp.) (Rge.)
 Operator Heathman & Co.
 Well No. 3 Farm Baumgartner
 Elev. 2185 Location C S L NW NW

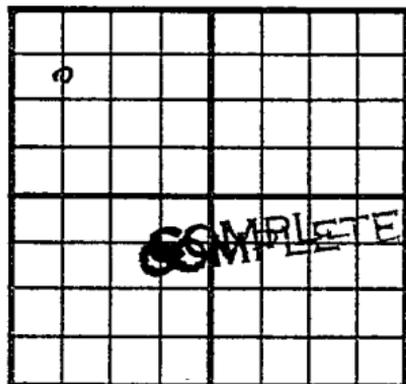

990 Ft. From N Line NW
660 Ft. From W Line Quarter
 Ist. Report _____
 Completion JUL 8 1953
 Remarks _____
Strain Drlg. - Contr.
 Spudding Date 6-4-53

Drlg. Data Oil well TD 3655
8" @ 155 Anhy 1567 Heeb. 3317
Tor. 3337 Lans. 3358 DST 3447-60
open 1 hr. Rec. 20' ocm 42' wcm
890# DST 3519-37 open 1/2 hr. Rec. 72' mu
& SSO 920# Arb. 3599 DST 3600-11
open 1/2 hr. Rec. 15' ocm 660# DST 3611-
32 open 1 hr. Rec. 315' vhocm 980#
DST 3632-55 open 1/2 hr. Rec. 2100' sw
5" @ 3654 CO to 3652 24/ 3642-50
Rec. 2000' wtr. CO to 3654 24/ 3630-35
B/ 5 lgo 15 gw SP 3625 23/ 3620-24
B/ 11 goph 500 A S/ 15 boph 13 bw
SP 3615 23/ 3600-09 S/ 13 boph
CO to 3622 S/ 17 boph 2000 A
 Comp. 1018 bopd

J. G. McGEHEE