

Section 29 Township 9 Range 18 WWell No. # 1 KoehlerCompany Heathman & Seeligson

						0	

NORTH

WEST

EAST

SOUTH

SEC.	TWP.	R.
29	9	18W

WELL NO.

#1 Koehler

FARM

COMPANY

Heathman & Seeligson

CONTRACTOR

Co. Tools.

Paradise Creek Pool

NORTH

Ft. from N. Line


990

Ft. from S. Line

990

Ft. from E. Line

Ft. from W. Line

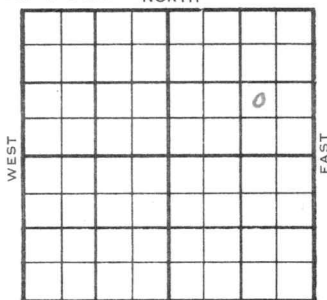


NW SE NE

SOUTH

	ELEVATION	REPORT
1953	2172'	
10/28	Spud 10-24-53 8" @ 188' WOC	
11/4	Top 3105' Heeb 3319' Tor 3340' Lans 3360' B KC 3569' Arb 3603' DST 3605'-10, 1/2 hr, 30' M DST 3606'-17, 40 mins, 12' M RTD 3617' 5" @ 3616	
11/11	CO 3611 41/3604-10 NS	
11/18	Spud 10-24-53 D & A TD 3638' 8" @ 188' Top 3105', Heeb 3319', Tor 3340' Lans 3360', B KC 3569, Arb 3603, DST 3605'-10' opn 1/2 hr, rec 30' Mud DST 3606'-17' opn 40 min, rec 12' Mud TD 3617' 5" @ 3616' CO to 3611 41/ 3604-10 1500 A CO to 3615 24/ 3610-14 2000 A DD 3638 FU 800' SW D & A	

ABANDONED

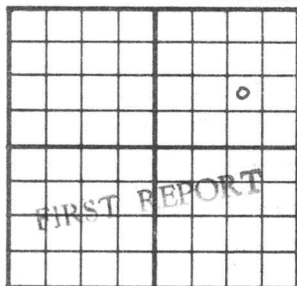
County Rooks State KansasSec. 29 (Blk.) 9 (Sur. Rge.) 18W Map No.Operator Heathman & SeeligsonWell No. 1 Farm KoehlerElev. Location NW SE NE990 Ft. From S Line NE990 Ft. From E Line Quarter1st. Report OCT 28 1953

Completion

Remarks

Co toolsSpudding Date 10-24-53Drlg. Data Paradise Creek Pool8" @ 188 WOC

County Rooks State Kansas
 Sec. 29 (Blk.) 9 (Sur.) 18W Map No.
 Operator Heathman & Seeligson
 Well No. 1 Farm Koehler
 Elev. 2172 Location NW SE NE

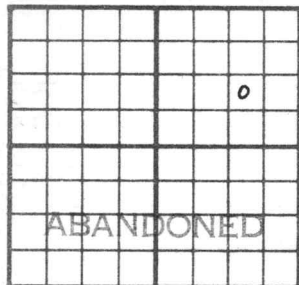

990 Ft. From S Line NE
990 Ft. From E Line Quarter

1st. Report

Completion NOV 18 1953

Remarks Paradise Creek Pool
Heathman - Contr.

Spudding Date 10-24-53

Drlg. Data D & A TD 3638

8" @ 188 Top. 3105 Heeb. 3319

Tor. 3340 Lans. 3360 B KC 3569

Arb. 3603 DST 3605-10 open $\frac{1}{2}$ hr.

Rec. 30' mud DST 3606-17 open 40 min.

Rec. 12' mud TD 3617 5" @ 3616

CO to 3611 41/ 3604-10 1500 A

CO to 3615 24/ 3610-14 2000 A

DD 3638 FU 800' SW

D & A

J. G. McGEHEE