


Section 29 Township 9 Range 18 W

Well No. # 1 Widman

Company G-M-R Oil

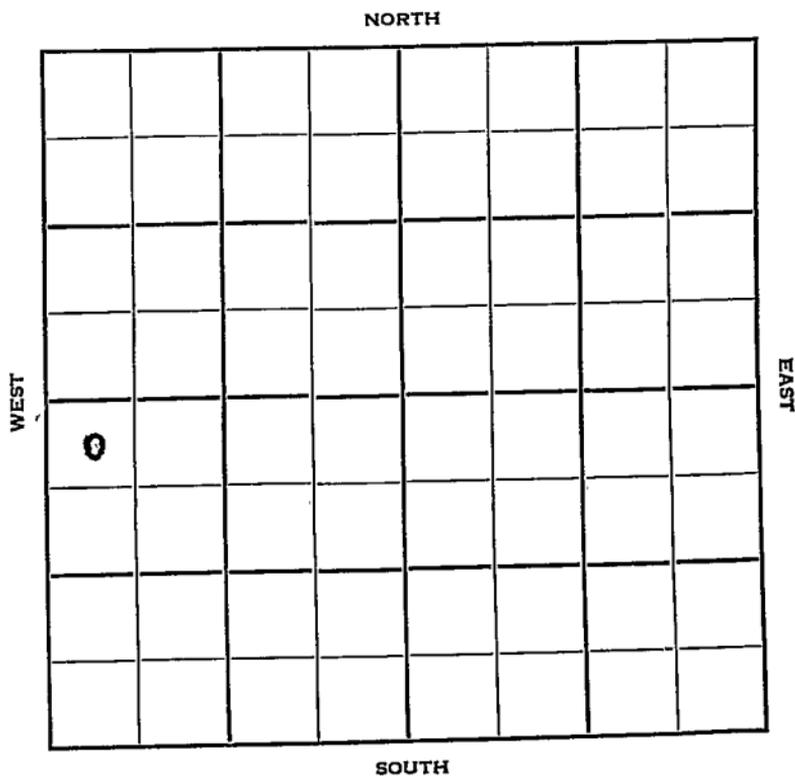

Sec. 29 Twp. 9 R. 18W

Well No. #1 Widman Farm

G-M-R Oil Company

G-M-R Contractor


330 Ft. from N. Line

Ft. from S. Line

Ft. from E. Line

330 Ft. from W. Line

NW NW SW

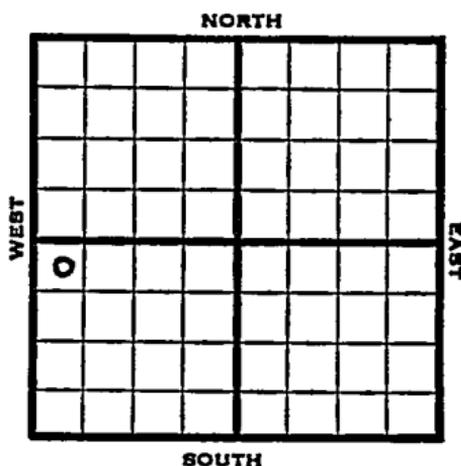

1953

Elev. 2186' REPORT

4/15

Spud 4-9-53  
8" @ 163  
Anhy 1575  
Drlg. 3182'

4/22

Spud 4-9-53  
D & A TD 3630 8" @ 163  
Anhy 1575 Heeb 3331 Tor 3352  
Lans 3371 Arb. 3623  
DST 3623-30 open 1 hr. rec 300' mud  
Off TD 3630 D & A

**ABANDONED**



County \_\_\_\_\_ Rooks State Kansas

Sec. 29 (Blk. Twp.) 9 (Sur. Rge.) 18W Map No. \_\_\_\_\_

Operator G-M-R Oil

Well No. 1 Farm Widman

Elev. 2186 Location NW NW SW


330 Ft. From N Line SW

330 Ft. From W Line Quarter

1st. Report

Completion APR 22 1953

Remarks

G-M-R - Contr.

Spudding Date 4-9-53

Drlg. Data D & A TD 3630

8" @ 163 Anhy 1575 Heeb. 3331

Tor. 3352 Lans. 3371 Arb. 3623

DST 3623-30 open 1 hr. Rec. 300' mud

O# TD 3630

D & A