

KANSAS Rocks

Section 29 Township 9 Range 19W

Well No. 2 Desmarteau


Company Petroleum Inc.

Wildcat

NORTH

WEST

EAST

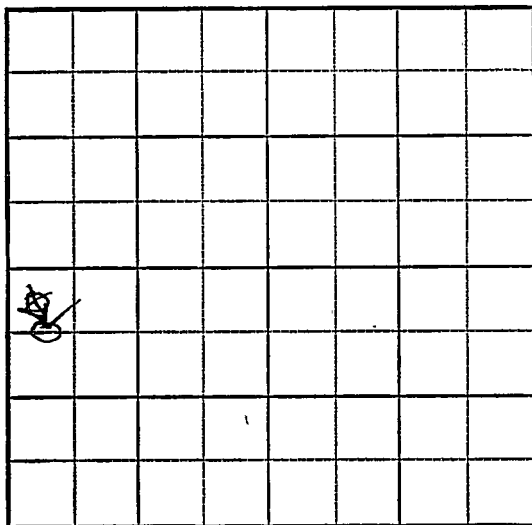

SOUTH

Sec. 29 Twp. 9 R. 19W

Well No. #2 Desmarteau Farm _____
Petroleum Inc. _____ Company


Wildcat

660
330' Ft. from N. Line

_____ Ft. from S. Line

_____ Ft. from E. Line

330' Ft. from W. Line

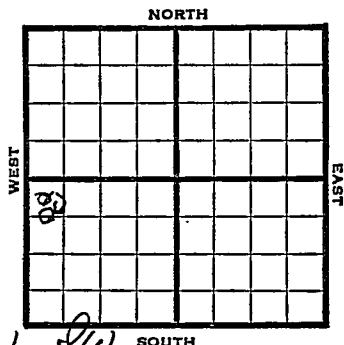

~~NW SW~~

CW & NW SW

SOUTH

1948 Elev. 2141' REPORT

9/29 8" @ 220'
Drlg. 1930'

10/6 Lansing 3360'
Arb. 3615
Drlg 3625'

10/13 Arb. 3615'
TD 3659'

ABANDONED

Map No. _____ Sec. 29 Twp. 9 R. 19WWell No. 2 Desmarteau_____
Petroleum Inc. _____ Company

FIRST REPORT

Contractor

NW SW.

SECTION PLAT

330 _____ Ft. from N. Line

_____ Ft. from S. Line

_____ Ft. from E. Line

330 _____ Ft. from W. Line

o			

Rooks County

Location _____

Rig up _____

Drilling and Remarks:

8" @ 220

drlg. 1930

RECORD

Cased _____ in., _____ ft.

Sand _____

Gas _____

Oil _____

Total Depth _____

PRODUCTION

1st 24 hrs. Nat. _____

1st 24 hrs. after shot _____

Gas _____ Cu. Ft.

Dry Hole _____

Abandoned _____

Date

SEP 29 1948

19

S. J. LEWIS

Scout

Rooks County Kansas State
 Map No. 65 Sec. 29 Twp. 9 R. 19W.

Well No. 2 Desmarteau

Petroleum Inc. Company

CORRECTION

Contractor

C W L NW SW

SECTION PLAT

660 Ft. from N. Line

 Ft. from S. Line

 Ft. from E. Line

330 Ft. from W. Line

Wildcat

Remarks:


Reported NW SW

Date

OCT 6 1948

Scout

S. J. LEWIS

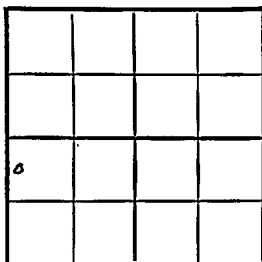Map No. 65 Sec. 29 Twp. 9 R. 19WWell No. 2 DesmarteauPetroleum Inc. Company**ABANDONED**C W L NW SW Contractor
E. 2141**SECTION PLAT**660 Ft. from N. Line Ft. from S. Line Ft. from E. Line330 Ft. from W. Line

Rooks County

Location Rig up Drilling and Remarks:
See 83615**RECORD**Cased in., ft.Sand Gas Oil Total Depth 2633**PRODUCTION**1st 24 hrs. Nat. 1st 24 hrs. after shot Gas Cu. Ft.Dry Hole Abandoned

Date

OCT 13 1948 19S. J. LEWIS Scout