

Section 29 Township 9 Range 20-WWell No. #1 GrahamCompany Nadel & Gussman

NORTH

WEST

EAST

SOUTH

14

0

KANSAS

Rooks

29

9

20-W ✓

Sec. _____ Twp. _____ R. _____

#1 Graham

Well No. _____ Farm _____

Nadel & Gussman

Company _____

Reserve Drlg. - Contr.

Wildcat _____ Contractor _____

_____ Ft. from N. Line

330


_____ Ft. from S. Line

330

_____ Ft. from E. Line

_____ Ft. from W. Line

SE SE SW

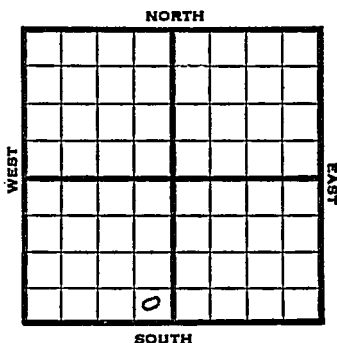

1951

Elev. 2268' REPORT

1/10


Spud 1-8-51
Drlg.

1/24

Spud 1-8-51
D&A TD 3935
8" @ 153' Anhy 1802
Heeb. 3562' Top. 3582
Lans. 3603 Cong. 3907'
TD 3935 D&A

ABANDONED

County Rooks State Kansas
 Sec. 29 (Blk. 9 (Sur. 20W Map No.
 (Twp.) (Rge.)
 Operator Nadel & Gussman
 Well No. 1 Farm Graham
 Elev. Location SE SE SW

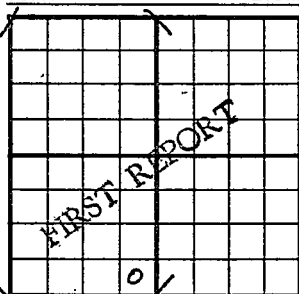

330 Ft. From S Line SW
330 Ft. From E Line Quarter
 1st. Report JAN 10 1951
 Completion
 Remarks
 Spudding Date 1-8-51

Drlg. Data

Wildcatdrlg.


J. E. TYRA

County Rooks State Kansas
 Sec. 29 (Blk.
Twp.) 9 (Sur.
Rge.) 20W Map No.

Operator Nadel & Gussman

Well No. 1 Farm Graham

Elev. 2268 Location SE SE SW

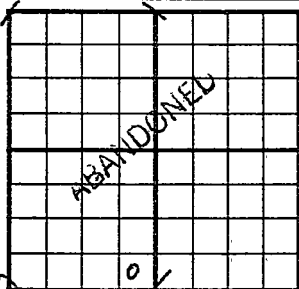

330 Ft. From S Line SW

330 Ft. From E Line Quarter

1st. Report

Completion JAN 24 1951

Remarks Wildcat

Reserve Drlg. - Contr.

Spudding Date 1-8-51

Drlg. Data D & A TD 3935

8" @ 153 Anhy 1802 Heeb. 3562 Top.

3582 Lans. 3603 Cong. 3907 TD 3935

D & A

J. E. TYRA