


Section 29 Township 9 Range 21W
 Well No. #1 Harold
 Company Cook & Galloway Drlg.

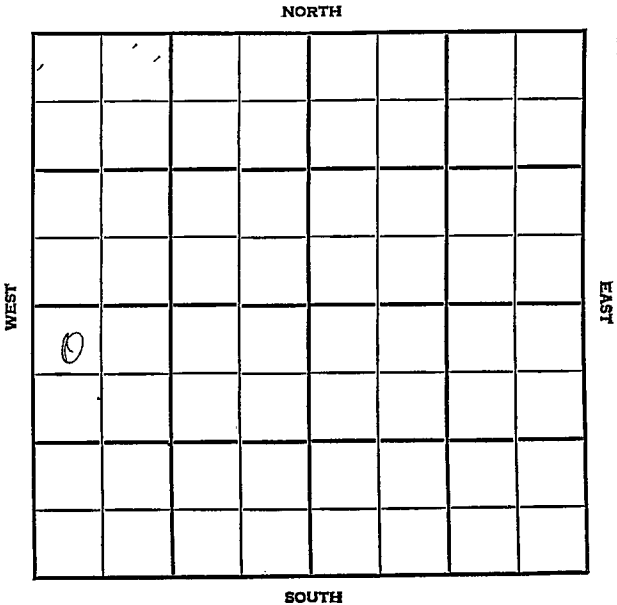

12

County Graham

Elev. _____

Sec. 29 Twp. 9NRge. 21WCompany Cook & Galloway Drlg.FarmName HaroldNo. 1

TOPS

DEPTH

LOG

DATUM

Loc. in Sec. _____

Anh. _____

Tp. _____

H. _____

Tr. _____

Dg. _____

Bl. _____

L. _____

K.C. _____

B.K.C. _____

Ce. _____

C. _____

M. _____

M. _____

K. _____

Mz. _____

Mo. _____

V. _____

S. _____

S. _____

A. _____

R. _____

PE. _____

G. _____

T.D. _____

NW NW SW

Geol. _____

Contr. _____

Co. Tools

Pool

FIRST REPORT

0

NOV 7 56

Date Comm. _____

Location _____

S. A. S. VON

County Graham Elev. 2309
 Sec. 29 Twp. (9) Rge. 21W
 Company Cook & Galloway Drilg.
 FarmName Harold No. 1

TOPS	DEPTH	LOG	DATUM	Loc. in Sec.
Anh.	1780			NW NW SW
TP.				
H.	3498			
Tr.				
Dg.				
BL				
L.	3533			Geol.
K.C.				Contr.
B.K.C.	3764			Co. Tools
Ce.				Pool
C.	3827			
M.				
M.				
K.				
Mz.				
Mo.				
V.				
S.				
S.				
A.	3932			ABANDONED NOV 23 '56
R.				
PE.				
G.				
TD.	3938			

Date Comm.

Location NOV 13 '55 NOV 21 '56 11-45-56

8 7/8 186/150 3225 NOV 28 '56

DST 3682-3755 1 hr per 20' md

BHP 1020

DEA