


Graham

KANSAS

SECTION 29 TOWNSHIP 9S RANGE 21W

WELL NO. #1 Eichman "B"

COMPANY K & E Drlg.

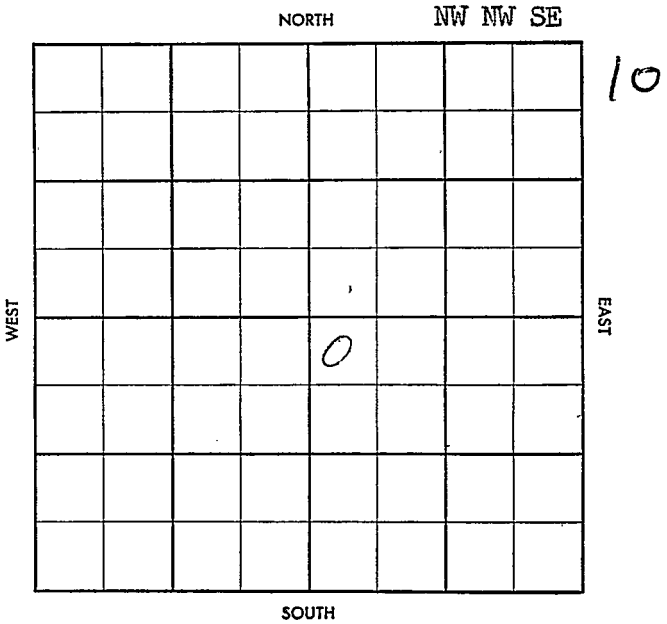

~~8~~

CO. Graham ELEV. _____
 SEC. 29 TWP. 9 RGE. 21W
 COMPANY K & E Drlg. NO. 1

FIRST REPORT	
9	
SEP 25	57

FARM Eichman "B"LOC. NW NW SE

GEOL. _____

CONTR. Co. toolsPOOL Harrold

SPUD _____

M I R

LSE.

NO.

SEC.

TWP.

RGE.

S-513-A

CO. Graham ELEV. 2336
 SEC. 29 TWP. 9 RGE. 21W
 COMPANY K & E Drlg. NO. 1

ABANDONED

OCT 16 57

FARM Eichman "B"LOC. NW NW SE

H 3535

TR 3561

L 3573

BKC 3798

Shc 3902

Chart c 3926

TD 3939

GEOL. _____

CONTR. Co. toolsPOOL HarroldSPUD 9-23-57

MIR OCT 2 57

85 138/150

D 3810 OCT 9 57

Lug tops TR 3168

H 3324 TR 3326

LKC 344 BKC 3636

A 3686 TD 3726 no

log no text

D & A

OCT 13 57

C

LSE.

NO.

SEC.

TWP.

RGE.