

WH8-DC21 ✓


Graham

KANSAS

SECTION 29 TOWNSHIP 9S RANGE 22W

WELL NO. #1 Sturgeon

COMPANY Woodman-Iannitti & E. J. Carter

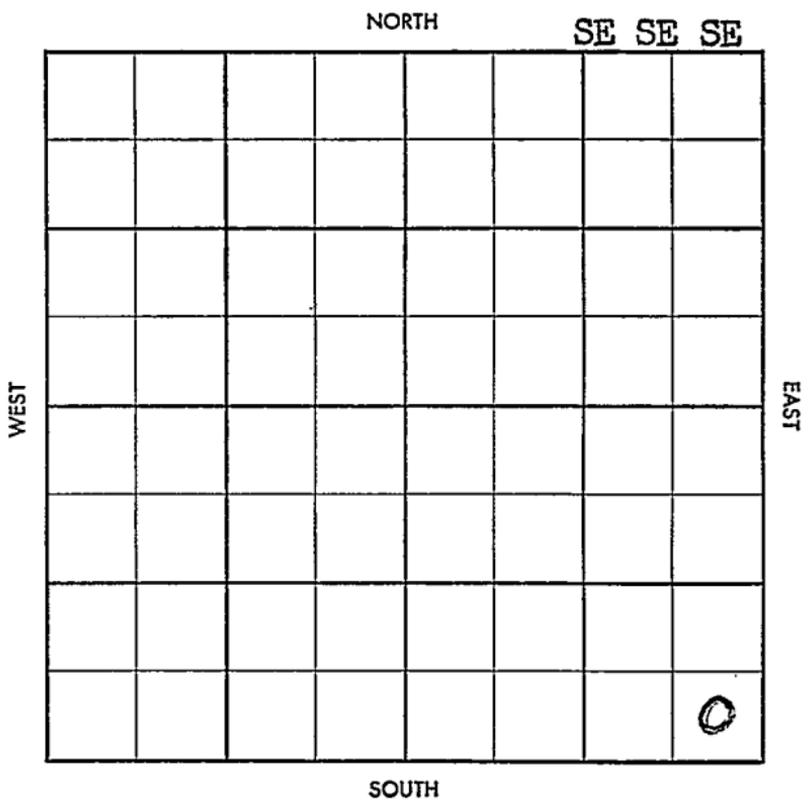

SEC. 29 TWP. 9 S R. 22 W

WELL NO. # 1 Sturgeon FARM

COMPANY Woodman-Iannitti & E. J. Carter  
~~Eugene J. Carter~~

CONTRACTOR Co. tools


Red Line

\_\_\_\_\_ FT. FROM N. LINE

\_\_\_\_\_ FT. FROM S. LINE

\_\_\_\_\_ FT. FROM E. LINE

\_\_\_\_\_ FT. FROM W. LINE

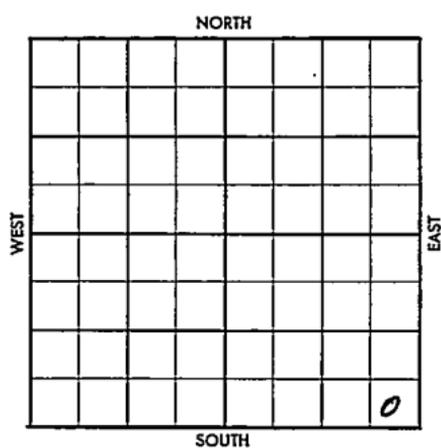

SE SE SE

Offset to SDX Prod.  
SDX-DHC-\$1,000.00 (S-12198)

1958 ELEVATION 2386' DF 2389' <sup>HP</sup>REPORT (WH8-DC21) ✓

5/7 Base Kansas City formation appx 4000'  
To be commenced by June 15, 1958  
To be completed by July 15, 1958  
(See copy DHC Agrt 5-7-58)

5/7 MIRT (FR Tkt)

5/8 Spud 5-5-58  
8-5/8" @ 163  
Drlg. 2570' (WH Dist. Wkly Drlg. Rpt)

5/15 Tops: Anhy 1905', Heeb 3598', Tor 3618', Lans 3632'  
DST 3622-82, open 1 hr, WB died 24", rec 50' M. BHP 1100# 10"  
DST 3680-3718', open 1 hr, rec 226' SOCMW, BHP 1200# 20". FP 140-360#  
DST 3759-3830', open 1 hr, rec 180' MW. BHP 1280# 20". To DD to 3870' and run log. (WH Dist Wkly Rpt)

5/22 TD 3870'. Ran log.  
Tops: Heeb 3596', Tor 3618', Lans. 3632', B.KC 3856' D & A 5-13-58 "

(Scout Completion ticket) ✓

**ABANDONED**

~~John P. ...~~  
~~...~~

County Graham Elev. \_\_\_\_\_  
Sec. 29 Twp. 9 Rge. 22W  
Company Woodman-Tannitti & E.J. Carter  
Farm Name Sturgeon No. 1

TOPS	DEPTH	LOG	DATUM
Anh.			
Tp.			
H.			
Tr.			
Dg.			
B.L.			
L.			
K.C.			
B.K.C.			
Ce.			
C.			
M.			
M.			
K.			
Mz.			
Mq.			
V.			
S.			
S.			
A.			
R.			
Pf.			
G.			
T.D.			

Loc. in Sec. \_\_\_\_\_  
SE SE SE  
WH 8-DC  
Geol. \_\_\_\_\_  
Contr. \_\_\_\_\_  
Co. Tools #1  
Pool \_\_\_\_\_  
Red Line

**REPORT**  
MAY 7 1958  
D.H.M. 0

Date Comm. May 7 1958  
M I R T

**MAY 9 1958**

**M. M.**

Co.  
Lse.  
No.  
Sec.  
T.  
R.

