

Graham

KANSAS


SECTION 29 TOWNSHIP 9 S RANGE 22 W

WELL NO. # 1 Manaugh

COMPANY Iron Drlg.

NORTH

NW SE NW

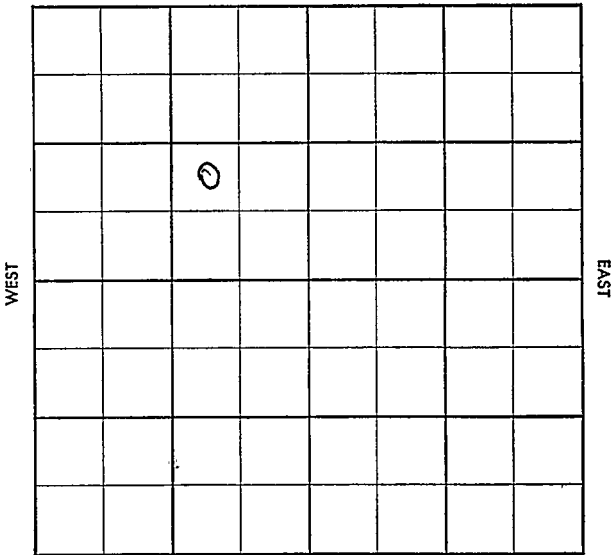

SOUTH

# WILDCAT



S-513-B

County Graham Elev. 2384 DF  
 Sec. 29 Twp. 9S Rge. 22W  
 Company Iron Drlg.  
 Farm Name Manaugh No. 1

TOPS	DEPTH	LOG	DATUM
Anh.	1905		
Tp.			
H.			
Tr.			
Dg.			
B.L.			
L.			
K.C.			
B.K.C.			
Ce.			
C.			
M.			
M.			
K.			
Mz.			
Mq.			
V.			
S.			
S.			
A.			
R.			
Pf.			
G.			
T.D.			

Loc. in Sec. NW SE NW

Geol. \_\_\_\_\_

Contr. \_\_\_\_\_

Pool \_\_\_\_\_

**Wildcat**

**FIRST REPORT**

SEP 11 1958

Date Comm. Pan American (F.O)  
8" @ 223, Drlg 2727

Co.

Lse.

No.

Sec.

T.

R.

~~Tw~~ ~~Pool~~ *21 line*

~~Co.~~ ~~Facet~~

5-513-B

County Graham Elev. 2384 DF 2387  
 Sec. 29 Twp. 9S Rge. 22W  
 Company Iron Drlg.  
 Farm Name Manaugh No. 1

TOPS	DEPTH	LOG.	DATUM
Anth.	1905		
TP.			
H.	3601		
Tr.			
Dg.			
B.L.			
L.			
K.C.	3639		
B.K.C.	3864		
Ce.			
C. <i>shly</i>	3870		
M.			
M.			
K.			
Mz.			
Mq.			
V.			
S.			
S.			
A. <i>2100</i>	4030		
* <i>Arb</i>	4049		
Pf.			
G.			
T.D.	4052		


Loc. In Sec. NW SE NW

Geol. \_\_\_\_\_

Contr. \_\_\_\_\_

Pool \_\_\_\_\_

Wildcat

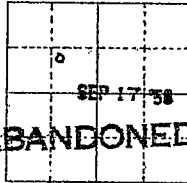

Date Comm. Pan American (P.O.)  
8 1/2 @ 223, Drlg 2727 SEP 17 '58 DST

3632-54 60" 25' 50CM FPO-0  
BHP 60 DST 3660-85 1 1/2 hrs  
55' 50C wtry m FPO-30 BHP 970  
DST 3800-43 60" 90' m FP 25-50  
BHP 1010

D&A

Co.  
No.  
Sec.  
T.  
R.

E1. 2384

TD 1668