


Section 29 Township 9 Range 23W

Well No. #1 Ernst

Company Empire Drlg. et al

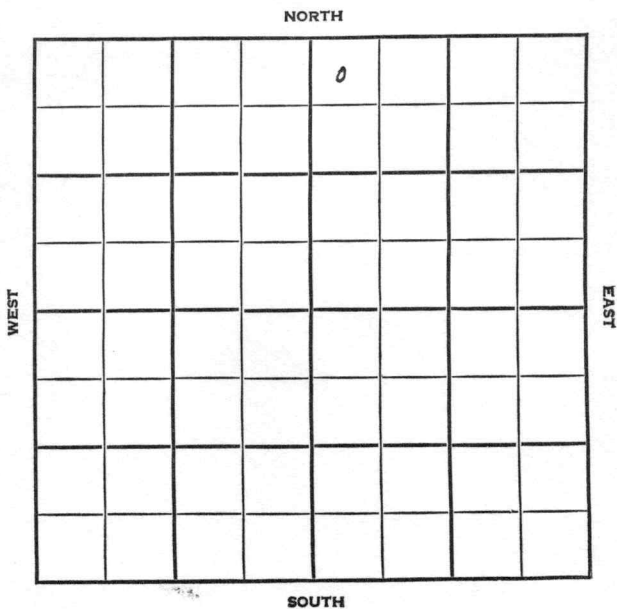

Graham KANSAS

SEC.	TWP.	R.
29	9	23W

WELL NO. 1 Ernst FARM

COMPANY Empire Drlg. et al

CONTRACTOR Co. Tools


Wildcat

330 Ft. from N. Line

\_\_\_\_\_ Ft. from S. Line

\_\_\_\_\_ Ft. from E. Line

330 Ft. from W. Line

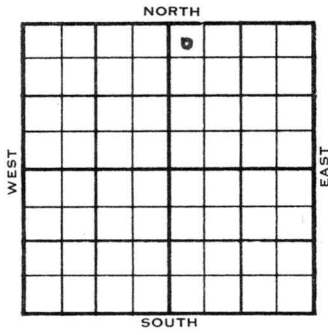

NW NW NE

1955	ELEVATION	REPORT
	2414'	

1/19

Spud 1-15-55  
8" @ 172'

2/2

Drlg. 1055'  
Spud 1-15-55  
D & A  
TD 4010'  
8" @ 172'  
Anhy 2028', Heeb 3726' Tor 3753'  
Lans 3764'  
TD 4010'  
D & A

ABANDONED



