


Section 3 Township 9 Range 16W

Well No. #6 Baxter

Company Broadview Oil

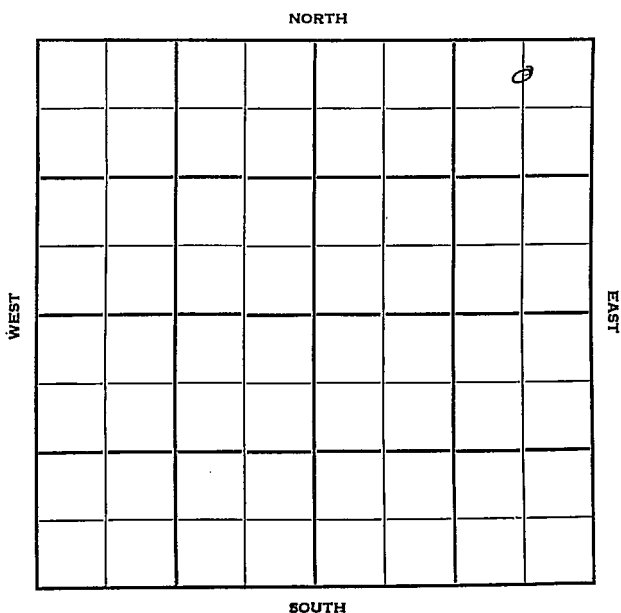

Sec. 3 Twp. 9 R. 16W

Well No. #6 Baxter Farm

Broadview Oil Company

Contractor

Laton Pool


330' Ft. from N. Line

Ft. from S. Line

660' Ft. from E. Line

Ft. from W. Line

C N L NE NE

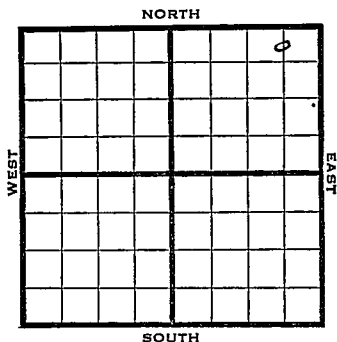

1949

Elev. 1951' REPORT

| | |
|-------|--------------------|
| 11/2 | Surface Hole |
| 11/9 | 8" @ 65' |
| | Lansing 3070' |
| | TD 3100' |
| | 5" @ 3100' |
| 11/16 | " |
| 11/23 | TD 3164' |
| | 5" @ 3100' |
| | 30' oil 6 hrs. |
| 11/29 | TD 3146' Corrected |
| | 2000 acid |
| | 500' oil |
| 12/7 | " |
| 12/14 | " |
| 12/21 | " |
| 12/28 | " |
| 3/1 | 8" @ 65' |
| | 5" @ 3100' |
| | Lans 3070' |
| | 20 BOPD |
| | TD 3170' |

COMPLETED

Map No. _____ Sec. 3 Twp. 9 R. 16W

Well No. 6 Baxter

Broadview Oil Company

Jayhawk Contractor
C N L NE NE

**FIRST REPORT
SECTION PLAT**

330 Ft. from N. Line

_____ Ft. from S. Line

660 Ft. from E. Line

_____ Ft. from W. Line

| | | | |
|--|--|--|---|
| | | | o |
| | | | |
| | | | |
| | | | |

Rooks County

Location _____

Rig up _____

Drilling and Remarks:

surface hole

RECORD

Cased _____ in., _____ ft.

Sand _____

Gas _____

Oil _____

Total Depth _____

PRODUCTION

1st 24 hrs. Nat. _____

1st 24 hrs. after shot _____

Gas _____ Cu. Ft.

Dry Hole _____

Abandoned _____

Date

NOV 2 1949 19

S. J. LEWIS Scout

Map No. _____ Sec. 3 ^{Kansas} Twp. 9 R. 16WWell No. 6 BaxterBroadview Oil

Company

Contractor

C N L N E N E

E. 1951
SECTION PLAT330 Ft. from N. Line

_____ Ft. from S. Line

660 Ft. from E. Line

_____ Ft. from W. Line



Rooks County

Location _____

Rig up _____

Drilling and Remarks:

8" @ 65
5" @ 3100
Leas 3070
20 BOPD

RECORD

Cased _____ in., _____ ft.

Sand _____

Gas _____

Oil _____

Total Depth 3170

PRODUCTION

1st 24 hrs. Nat. _____

1st 24 hrs. after shot _____

Gas _____ Cu. Ft.

Dry Hole _____

Abandoned _____

Date

MAR 1 1950 19

J. E. TYRA

Scout