




Sec. 3 Twp. 9 R. 16W

Well No. 5 Baxter "E" Farm

Broadview Oil Company

Laton Pool

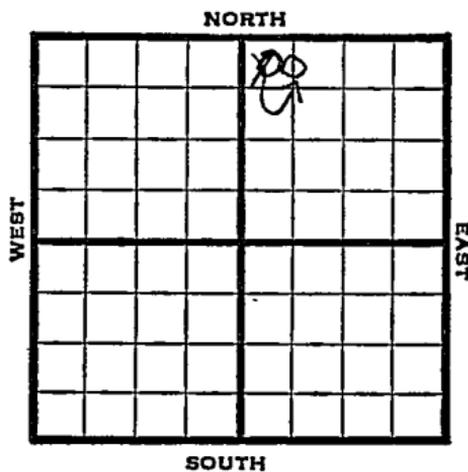

330 Ft. from N. Line

\_\_\_\_\_ Ft. from S. Line

\_\_\_\_\_ Ft. from E. Line

660'

~~330~~

\_\_\_\_\_ Ft. from W. Line

~~NW NE~~ C N L NW NE

1948

Eli 1924'

REPORT

9/22

8" @ 195'  
Topeka 2796'  
Lans. 3055'  
T.D. 3285'

9/29

5" @ 3285'  
PB 3262'  
24 shots 3249-58  
17 shots 3238-45  
17 shots 3218-24 2000 acid sqz.

10/6

Did not squeeze 12000 acid  
Pump 40 bbls oil 24 hrs.

10/13

"

10/20

TD 3285'  
Lansing 3055'  
5"@ 3285'  
Perf 14,000 acid  
Pump 40 oil Pot  
27° Gr.  
Comp

**COMPLETED**

Rooks County Kansas State  
 Map No. \_\_\_\_\_ Sec. 3 Twp. 9 R. 16W  
 Well No. 5 Baxter "E"  
Broadview Oil Company

**FIRST REPORT**

Contractor

NW NE

**SECTION PLAT**

330 Ft. from N. Line  
 \_\_\_\_\_ Ft. from S. Line  
 \_\_\_\_\_ Ft. from E. Line  
330 Ft. from W. Line

			o		

Laton Pool

Remarks:

8" @ 195 Topeka 2796 Lans. 3055  
 TD 3285 5" @ 3285

Date  
 SEP 22 1948

Scout  
 S. J. LEWIS

Rooks County Kansas State

Map No. 64 Sec. 3 Twp. 9 R. 16W

Well No. 5 Baxter "E"

Broadview Oil Company

CORRECTION

Contractor

C N L NW NE

SECTION PLAT

330 Ft. from N. Line

Ft. from S. Line

Ft. from E. Line

660 Ft. from W. Line

				φ			

Laton Pool

Remarks:

Reported NW NE

Date

SEP 29 1948

Scout

S. J. LEWIS

Map No. 64 Sec. 3 Twp. 9 R. 16W

Well No. 5 Baxter "E"

Broadview Oil

Company

**COMPLETE**

Contractor

C N L NW NE

E 11924  
**SECTION PLAT**

330 Ft. from N. Line

\_\_\_\_\_ Ft. from S. Line

\_\_\_\_\_ Ft. from E. Line

660 Ft. from W. Line

		o	

Rooks County

**RECORD**

Location \_\_\_\_\_

Cased \_\_\_\_\_ in., \_\_\_\_\_ ft.

Rig up \_\_\_\_\_

Sand \_\_\_\_\_

Drilling and Remarks:

Gas \_\_\_\_\_

Oil

Total Depth 3250

\_\_\_\_\_

\_\_\_\_\_

**PRODUCTION**

1st 24 hrs. Nat. \_\_\_\_\_

1st 24 hrs. after shot \_\_\_\_\_

Gas \_\_\_\_\_ Cu. Ft.

Dry Hole \_\_\_\_\_

Abandoned \_\_\_\_\_

*Line 3055*  
*5" @ 3250*  
*Perf*  
*1400 casing*  
*Perf 40 in @ 3250*  
*27 1/2 ft*

Date

OCT 20 1948

19

**S. J. LEWIS**

Scout