

KANSAS

Rooks

FORM 51 5M 4-41 PETROL


Section 3 Township 9 Range 16-W

Well No. 2 Reese

Company Cities Service Oil et al

Laton pool

NORTH

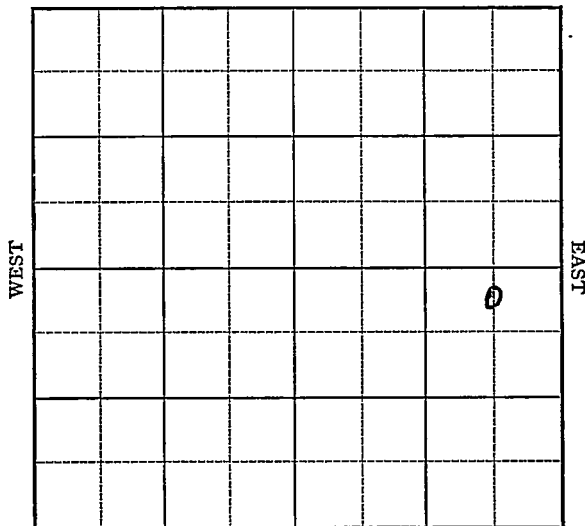

SOUTH

Sec. 3 Twp. 9 R. 16-W

Well No. #2 Reese Farm

Cities Service Oil et al Company

(Laton)


330 Ft. from N. Line

_____ Ft. from S. Line

660 Ft. from E. Line

_____ Ft. from W. Line

Elev. 1967

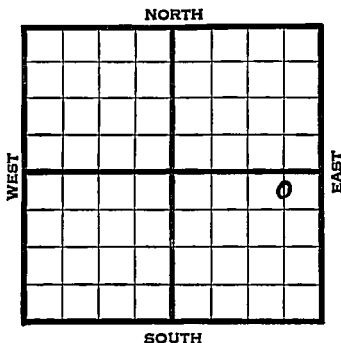

1941	REPORT
8/20	8" - 148' WOC.
8/21	" " "
8/28	Drllg. 2965'
9/4	Lans. 3093' 5" - 3130'
	T.D. 3170' S.S.O. Shut down.
9/11	8000 acid. Pump 3 oil per hour.
9/18	177 Pot.
9/25	T.D. 3182' 3000 acid.
	Pump 120 oil in 24 hours.
10/2	Pump 120 bbls. oil 24 hours.
10/8	Lans. 3093'
	5" - 3130'
	T.D. 3182'
	6000 acid.
	Potential 177 bbls., pump.
	38. Gravity
	COMPLETED

KANSAS

Map No. 64 Sec. 3 Twp. 9 R. 16W

Well No. 2 Reese

Cities Service Oil etal Company

~~FIRST REPORT~~ Contractor

C N L N E S E

SECTION PLAT

330 Ft. from N. Line

			o

_____ Ft. from S. Line

660 Ft. from E. Line

_____ Ft. from W. Line

LATON POOL

Location _____

RECORD

Rig up _____

Cased _____ in., _____ ft.

Drilling and Remarks:

Sand _____

8" - 148 WOC

Gas _____

Oil _____

Total Depth _____

PRODUCTION

1st 24 hrs. Nat. _____

1st 24 hrs. after shot _____

Gas _____ Cu. Ft.

Dry Hole _____

Abandoned _____

Date

AUG 20 1941

19

S. J. LEWIS

Scout

