


Section 3 Township 9 Range 16W

Well No. #4 Gamble

Company Vickers

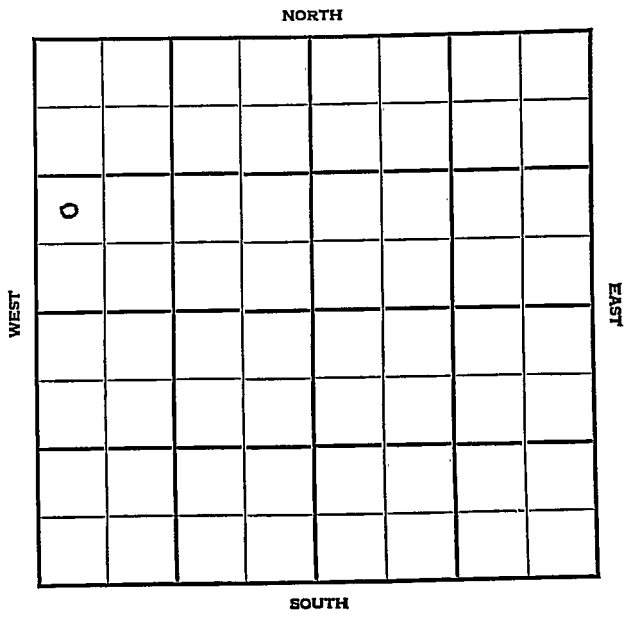



Sec. 3 Twp. 9 R. 16W

Well No. #4 Gamble Farm  
Vickers Company

Laton Pool


\_\_\_\_\_ Ft. from N. Line

990' Ft. from S. Line

\_\_\_\_\_ Ft. from E. Line

330' Ft. from W. Line

NW SW NW

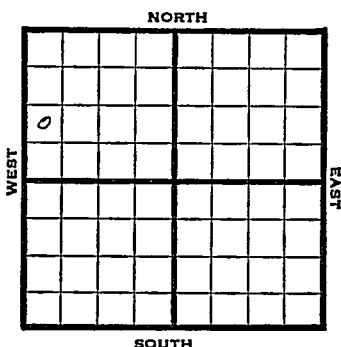

1948

Elev. 1966' REPORT

5/19

Location

5/26

8" @ 274'  
Drlg. 2050'

6/1

Lansing 3075'  
Arbuckle 3416'  
TD 3422'  
5" @ 3422'  
RUST

6/9

36 shots 3260 to 3275' CO

6/16

"

6/23

2000 acid  
750 fluid 16 hrs.  
50% W

6/30

Lans. 3075'  
Arbuckle 3416'  
5" @ 3422'  
Perf Lans.  
2000 acid  
Pump 50 oil & 35 W Pot.  
Gr. 27.5°  
TD 3422'

**COMPLETED**

Map No. \_\_\_\_\_ Sec. 3 Twp. 9 R. 16W

Well No. 4 Gamble

Vickers Company

**FIRST REPORT** Contractor

NW S WNW

SECTION PLAT

\_\_\_\_\_ Ft. from N. Line

990 Ft. from S. Line

\_\_\_\_\_ Ft. from E. Line

330 Ft. from W. Line

o			

Rooks County

Location X

Rig up \_\_\_\_\_

Drilling and Remarks:

RECORD

Cased \_\_\_\_\_ in., \_\_\_\_\_ ft.

Sand \_\_\_\_\_

Gas \_\_\_\_\_

Oil \_\_\_\_\_

Total Depth \_\_\_\_\_

PRODUCTION

1st 24 hrs. Nat. \_\_\_\_\_

1st 24 hrs. after shot \_\_\_\_\_

Gas \_\_\_\_\_ Cu. Ft.

Dry Hole \_\_\_\_\_

Abandoned \_\_\_\_\_

Date

MAY 19 1948 19

S. J. LEWIS Scout

