

KANSAS

Rooks

Section 3 Township 9 Range 16W

Well No. 5 Gamble

Company Vickers

Laton

NORTH

WEST

EAST

0							

SOUTH

Sec. 3 Twp. _____ R. _____

Well No. #5 Gamble Farm _____

Vickers Company _____

Laton Pool (Jayhawk Drlg., Contr.)


330' Ft. from N. Line

_____ Ft. from S. Line

_____ Ft. from E. Line

330' Ft. from W. Line

NW SW

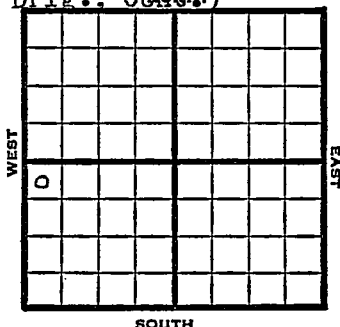

1949

Elev 1991' REPORT

10/19

Surface Hole

10/26

8" @ 92'
Drlg. 3088'

11/1

Lansing 3104'
TD 3320'

5" @ 3320'

11/9

"

11/16

TD 3320'
Lans 3104'
5" @ 3320'
Perf 3000 acid
Pump 75 Oil / 20% W Pot
27° Gr.
Comp

COMPLETED

Map No. _____ Sec. 3 Twp. 9 R. 16W

Well No. 5 Gamble

Vickers Company

Jayhawk Drlg. Contractor

NW SW

FIRST REPORT
SECTION PLAT

330 Ft. from N. Line

_____ Ft. from S. Line

_____ Ft. from E. Line

330 Ft. from W. Line

o			

Rooks County

Location _____

Rig up _____

Drilling and Remarks:

surface hole

RECORD

Cased _____ in., _____ ft.

Sand _____

Gas _____

Oil _____

Total Depth _____

PRODUCTION

1st 24 hrs. Nat. _____

1st 24 hrs. after shot _____

Gas _____ Cu. Ft.

Dry Hole _____

Abandoned _____

Date

OCT 19 1949 19

S. J. LEWIS Scout

Map No. _____ Sec. 3 Twp. 9 R. 16W

Well No. 5 Gamble

Vickers Company

COMPLETE

Contractor

NW SW

E. 1991

SECTION PLAT

330 Ft. from N. Line

_____ Ft. from S. Line

_____ Ft. from E. Line

330 Ft. from W. Line

o			

Rooks County

Location _____

Rig up _____

Drilling and Remarks:

Lease 8104
5" c3320
Prof. 3000 acid
Prod. 75 oil + 20% w
SS
27⁹ SW

RECORD

Cased _____ in., _____ ft.

Sand _____

Gas _____

Oil _____

Total Depth 3320

PRODUCTION

1st 24 hrs. Nat. _____

1st 24 hrs. after shot _____

Gas _____ Cu. Ft.

Dry Hole _____

Abandoned _____

Date

NOV 16 1949 19

S. J. LEWIS Scout