

KANSAS

Rooks

Section 3 Township 9 Range 18WWell No. 1 WildrixCompany Cities Service

Yohe

NORTH

0							

WEST

EAST

SOUTH

KANSAS Rooks

Sec. 3 Twp. 9 R. 18W ✓

Well No. #1 Wildrix Farm

Cities Service Company


Yohe Pool

Ft. from N. Line

330' Ft. from S. Line

Ft. from E. Line

330' Ft. from W. Line

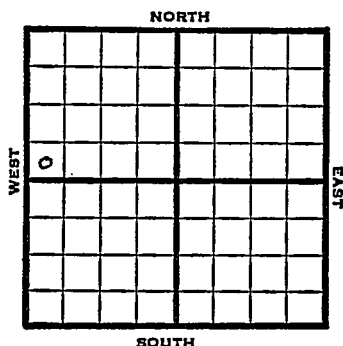

SW NW

1949	Elev 1984'	REPORT
7/13	RUR	
7;20	8"@ 286'	
	Drlg 2400'	
7/27	Lansing 3165'	
	TD 3370'	
	5"@ 3370'	
8/3	PB 3320'	
	81 shots 3234-3262-2500 acid	
	pump 150 bbls oil / 136 W 24 hrs.	
8/10	"	
8/17	"	
8/24	"	
8/31	TD 3370'	
	Lans 3165'	
	5"@ 3370'	
	Perf	
	2500 acid	
	Pump 160 oil / 30 W Pot	
	27° Gr.	
	Comp	
	COMPLETED	

Yohe Pool

Kansas

18W


Map No. _____ Sec. 3 Twp. 9 R. _____

Well No. 1 Wildrix _____

_____ Cities Service _____ Company

_____ Contractor

SW NW

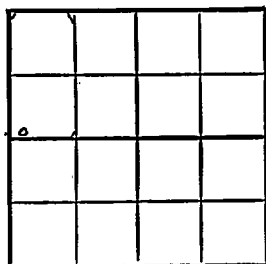FIRST REPORT
SECTION PLAT

_____ Ft. from N. Line

330

_____ Ft. from S. Line

_____ Ft. from E. Line

330

_____ Ft. from W. Line

Rooks County

Location _____

Rig up _____

Drilling and Remarks:

R U R

RECORD

Cased _____ in., _____ ft.

Sand _____

Gas _____

Oil _____

Total Depth _____

PRODUCTION

1st 24 hrs. Nat. _____

1st 24 hrs. after shot _____

Gas _____ Cu. Ft.

Dry Hole _____

Abandoned _____

Date

JUL 13 1949

19

S. J. LEWIS

Scout

Kansas

Map No. K64 Sec. 3 Twp. 9 R. 18WWell No. 1 Wildrix

Cities Service

Company

COMPLETE

Contractor

SW NW

8.1.1984
SECTION PLAT

Ft. from N. Line


330

Ft. from S. Line

Ft. from E. Line

330

Ft. from W. Line

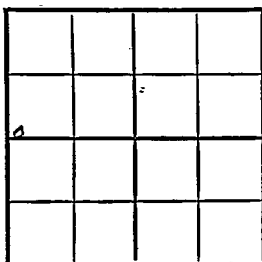

Rooks County

RECORD

Location

Cased _____ in, _____ ft.

Rig up

Sand _____

Drilling and Remarks:

Gas _____

Oil _____

Total Depth 3370

PRODUCTION

1st 24 hrs. Nat. _____

1st 24 hrs. after shot _____

Gas _____ Cu. Ft.

Dry Hole _____

Abandoned _____

Date

AUG 31 1949

19

S. J. LEWIS

Scout

Liam 3/655" C3370Prof.
2500 cu. ft.Pump 160 oil 730W. P. 2722