


KANSAS

Section 3 Township 9 Range 19W

Well No. #1 Lindquist

Company Petroleum, Inc.

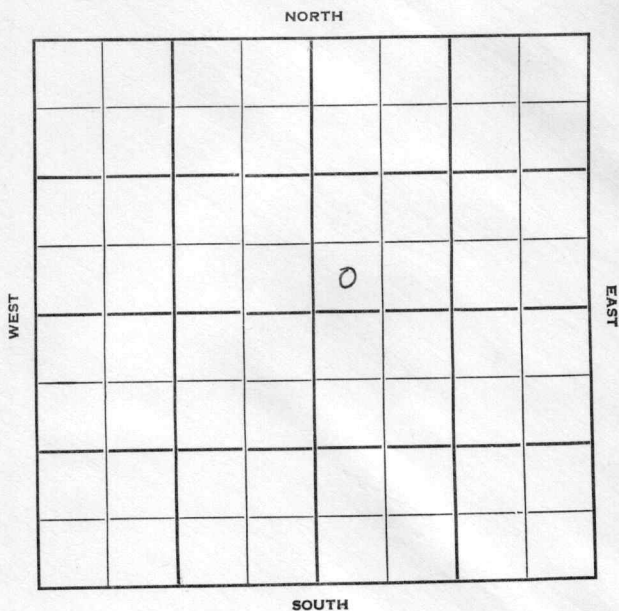

Sec. 3 Twp. 9 R. 19W

Well No. #1 Lindquist Farm

Petroleum, Inc. Company

Webster Pool (B & R Drlg, Contr.)


 Ft. from N. Line

330' Ft. from S. Line

 Ft. from E. Line

330' Ft. from W. Line

SW NE

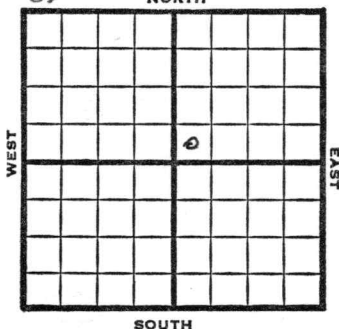

1949

Elev 2014'

REPORT

12/28
1950
1/11

RUR

Anh 3145'

Heb 3181'

Lan 3220'

BKC 3425'

DST 3400-20

No shows.

TD 3456'

D&A

Aband.

ABANDONED

Kansas

Webster Pool

Map No. _____ Sec. 3 Twp. 9 R. 19WWell No. 1 Lindquist

Petroleum Inc.

Company

B & R Drlg.

Contractor

SW NE

FIRST REPORT
SECTION PLAT

Ft. from N. Line


330

Ft. from S. Line

Ft. from E. Line

330

Ft. from W. Line

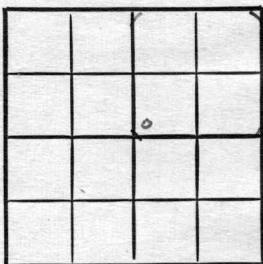

Rooks County

Location _____

Rig up _____

Drilling and Remarks:

R U R

RECORD

Cased _____ in., _____ ft.

Sand _____

Gas _____

Oil _____

Total Depth _____

PRODUCTION

1st 24 hrs. Nat. _____

1st 24 hrs. after shot _____

Gas _____ Cu. Ft.

Dry Hole _____

Abandoned _____

Date

DEC 28 1949

19

S. J. LEWIS

Scout

Map No. _____ Sec. 3 Twp. 9 R. 19WWell No. 1 Lindquist_____
Petroleum Inc. _____ Company_____
Contractor

SW NE

Edv. 2014
SECTION PLAT_____
Ft. from N. Line330 Ft. from S. Line_____
Ft. from E. Line330 Ft. from W. Line

Rooks County

Location _____

Rig up _____

Drilling and Remarks:

*Anh-3145**Feb 3181**Lan 3220**BKC 3425**DST 3400-20**no shows**T.D. 3456 - DTA*

RECORD

Cased _____ in., _____ ft.

Sand _____

Gas _____

Oil _____

Total Depth _____

PRODUCTION

1st 24 hrs. Nat. _____

1st 24 hrs. after shot _____

Gas _____ Cu. Ft.

Dry Hole _____

Abandoned ☒

Date

JAN 11 1950 19

J. E. TYRA

Scout