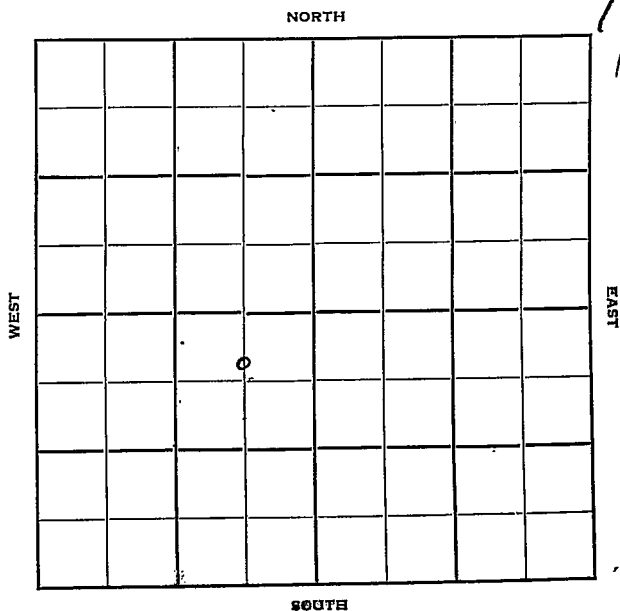


Section 3 Township 9 Range 19-WWell No. #3 Rosocil (a)Company Shio & Petroleum Inc.

Rooks

KANSAS

Sec. 3 Twp. 9 R. 19W ✓

Well No. #3 Rosocil (A) Farm

Sohio & Petroleum, Inc. Company

Contractor


495' Ft. from N. Line

Ft. from S. Line

660' Ft. from E. Line

Ft. from W. Line

C S/2 NE SW

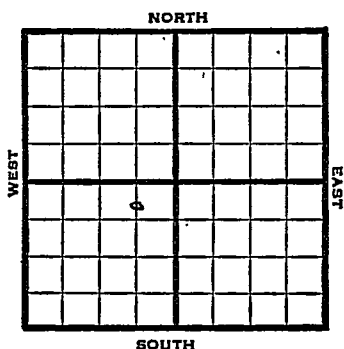

1950

Elev 2037

REPORT

5/17

Location

6/21

10" @ 328

DST 3115-26

open 30 min, rec 335' oil & SW

Dodge 3187

Lans 3208

DST 3208-34, opn 1 hr, rec 75' ocm 30' oil

DST 3360-90 opn 1 hr rec 180' hocom

DST 3403-18 opn 1 hr rec 30' ocm

Arb 3454-60

5" @ 3456

TD 3460

S/5½ boph

500 acid

test 5556 bopd

Comp for maximum well

Ind capacity 22,999 bopd

Completed

COMPLETED

Map No. _____ Sec. 3 _____ Twp. 9 _____ R. 19W

Well No. 3 Rosocil (a) _____

Schio & Petroleum Inc. _____ Company

_____ Contractor

C S/2 NE S¹/₄

SECTION PLAT

405 _____ Ft. from N. Line

_____ Ft. from S. Line

660 _____ Ft. from E. Line

_____ Ft. from W. Line

FIRST REPORT			
	o		

Rocks

Location X _____

Rig up _____

Drilling and Remarks:

RECORD

Cased _____ in., _____ ft.

Sand _____

Gas _____

Oil _____

Total Depth _____

PRODUCTION

1st 24 hrs. Nat. _____

1st 24 hrs. after shot _____

Gas _____ Cu. Ft.

Dry Hole _____

Abandoned _____

Date

MAY 17 1950
19

J. E. TYRA Scout

Kansas

Map No. _____ Sec. 3 Twp. 9 R. 19WWell No. 3 Rostocil "A"

Sohio & Petroleum Inc. Company

Contractor

#1. 2037

SECTION PLAT


C S L NE SW

495 Ft. from N. Line

Ft. from S. Line

660 Ft. from E. Line

Ft. from W. Line

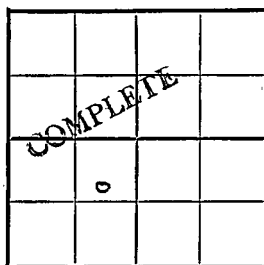

Rooks County

Location _____

Rig up _____

Drilling and Remarks:

10" @ 328

DST 3115-26

open 30 min.

Rec. 335⁺ oil &
salt water

Dodge 3187

Lens. 3208

RECORD

Cased _____ in., _____ ft.

Sand _____

Gas _____

Oil _____

Total Depth 3460

PRODUCTION

1st 24 hrs. Nat. _____

1st 24 hrs. after shot _____

Gas _____ Cu. Ft.

Dry Hole _____

Abandoned _____

Date

JUN 21 1950

19

J. E. TYRA

Scout

DST 3208-3410

open 1 hour

Rec. 75' ocm

DST 3360-90

open 1 hour

Red. 180' hocr

DST 3403-18

open 1 hour

Rec. 30' ocm

Arb. 3454-60

5" @ 3456

TD 3460

S/ 5 1/2 boph

Scout Cards	7 (4)
Land Small Map	
Land Wall Map	
Tracings	
France Map	
Pierce Map	
Misc.	

JUN 29 1962

500 acid

test 3556 bopd

Comp for maximum well

Ind. capacity 22,999 bopd

RECORD